


WELL PLUGGING RECORD

Give All Information Completely
Make Required Affidavit
Mail or Deliver Report to:
Conservation Division
State Corporation Commission
800 Bittling Building
Wichita, Kansas

NORTH

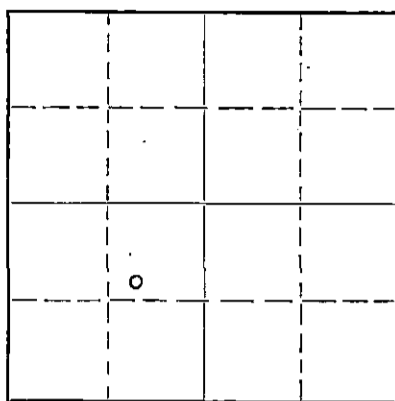

Locate well correctly on above
Section Plat

Stafford County, Sec. 11 Twp. 22S Rge. 12 (E) (W)
Location as "NE/CNW $\frac{1}{4}$ SW $\frac{1}{4}$ " or footage from lines S/2 NE/4 SW/4
Lease Owner Stanolind Oil and Gas Company
Lease Name C. Voight "A" Well No. 2
Office Address Box 1654, Oklahoma City, Oklahoma
Character of Well (completed as Oil, Gas or Dry Hole) Dry Hole
Date well completed 10-10- 19 50
Application for plugging filed 10-10- 19 50
Application for plugging approved 10-13- 19 50
Plugging commenced 10-10- 19 50
Plugging completed 10-11- 19 50
Reason for abandonment of well or producing formation Dry hole when drilled.

If a producing well is abandoned, date of last production 19
Was permission obtained from the Conservation Division or its agents before plugging was commenced? Yes by well wire

Name of Conservation Agent who supervised plugging of this well G. D. Stough
Producing formation Arbuckle Depth to top 3670 Bottom 3758 Total Depth of Well 3758 Feet
Show depth and thickness of all water, oil and gas formations.

OIL, GAS OR WATER RECORDS

CASING RECORD

Formation	Content	From	To	Size	Put In	Pulled Out
Arbuckle	Oil	3670	3758	8-5/8	637	None

Describe in detail the manner in which the well was plugged, indicating where the mud fluid was placed and the method or methods used in introducing it into the hole. If cement or other plugs were used, state the character of same and depth placed, from _____ feet to _____ feet for each plug set.
3758' - 260' Heavy Mud
260' - 30' 35 sax cement on top of plug
30' - 0' 15 sax cement on top of plug

(If additional description is necessary, use BACK of this sheet)

Correspondence regarding this well should be addressed to G. A. Younie
Address Box 7, Ellinwood, Kansas

STATE OF Kansas, COUNTY OF Barton, ss.
G. A. Younie (employee of owner) or (owner or operator) of the above-described well,

being first duly sworn on oath, says: That I have knowledge of the facts, statements, and matters herein contained and the log of the above-described well as filed and that the same are true and correct. So help me God.

(Signature) *G. A. Younie* Field Supt.
Box 7, Ellinwood, Kansas
(Address)

SUBSCRIBED AND SWORN TO before me this 24th day of October, 19 50

My commission expires November 14, 1953

23-8273-s 4-50-10M

PLUGGING
FILE SEC 11 T 22 R 12 W
BOOK PAGE 35 LINE 2

Notary Public
STATE CORPORATION COMMISSION
NOV 22 1950 11-22-50
CONSERVATION DIVISION
Wichita, Kansas

FORMATION RECORD

DESCRIBE EACH FORMATION DRILLED. INDICATE THICKNESS, CONTENT AND WHETHER DRY, OR OIL, GAS, OR WATER BEARING.

FORMATION	TOP	BOTTOM	FORMATION	TOP	BOTTOM
Sand and shale <u>Surface</u>	0	275			
Red bed	275	632			
Anhydrite	632	710			
Shale and shells	710	785			
Shale and salt	785	1200			
Shale and shells	1200	1545			
Shale and lime	1545	1715			
Lime - Shale streaks	1715	1965			
Lime	1965	2055			
Sand	2055	2100			
Shale and sand	2100	2235			
Lime and shale	2235	2975			
Broken lime	2975	3050			
Lime	3050	3200			
Lime and shale	3200	3300			
<u>Top of lensing</u>		3300			
Lime	3300	3458			
Shale and lime	3458	3487			
Soft lime	3487	3495			
Lime	3495	3532			
Lime and shale	3532	3546			
Lime	3546	3564			
Lime and chert	3564	3605			
Lime	3605	3616			
Shale	3616	3670			
<u>Top of Arbuckle</u>		3670			
<u>Lime</u>	3670	3758			
Top Lensing		3300			
Top Arbuckle		3670			
Total Depth					
By Radiation Log		3755			
By Rotary Drill		3750			
D.S.T. 1 hr. - Rec.					
25' mud - no show - no BHP					
Completed as a dry hole					
October 11, 1950					

PLUGGING

FILE SEC - (L.T.V.V.R.L.V.)

BOOK PAGE 35 LINE 2