

STATE OF KANSAS  
STATE CORPORATION COMMISSION


WELL PLUGGING RECORD

Give All Information Completely  
Make Required Affidavit  
Mail or Deliver Report to:  
Conservation Division  
State Corporation Commission  
211 No. Broadway  
Wichita, Kansas

Stafford County. Sec. 11 Twp. 22S Rge. 12 (E) W (W)

Location as "NE/CNW/SW" or footage from lines SE/4 SW/4 SE/4  
Lease Owner Albert M. Austin  
Lease Name Voigt Well No. 1  
Office Address 522 Union National Bldg., Wichita 2, Kansas  
Character of Well (completed as Oil, Gas or Dry Hole) Dry Hole  
Date well completed April 17, 19 57  
Application for plugging filed (verbal) April 18, 19 57  
Application for plugging approved (verbal) April 18, 19 57  
Plugging commenced April 18, 19 57  
Plugging completed April 18, 19 57  
Reason for abandonment of well or producing formation Dry Hole

NORTH

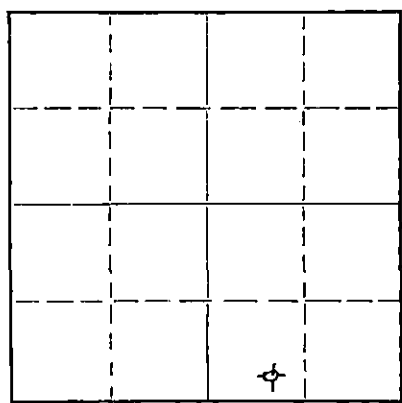

Locate well correctly on above Section Plat

If a producing well is abandoned, date of last production 19  
Was permission obtained from the Conservation Division or its agents before plugging was commenced? YES

Name of Conservation Agent who supervised plugging of this well R. M. Brundage  
Producing formation Depth to top Bottom Total Depth of Well 3685 Feet  
Show depth and thickness of all water, oil and gas formations.

OIL, GAS OR WATER RECORDS

CASING RECORD

FORMATION	CONTENT	FRDM	TO	SIZE	PUT IN	PULLED OUT
		0	214'	8-5/8"	214'	none

Describe in detail the manner in which the well was plugged, indicating where the mud fluid was placed and the method or methods used in introducing it into the hole. If cement or other plugs were used, state the character of same and depth placed, from feet to feet for each plug set.

1/3 sack hulls and plug set at 210 feet.  
20 sacks cement mixed and poured through drill pipe.  
Top plug set at 20 feet. 5 sacks cement mixed and poured.

(If additional description is necessary, use BACK of this sheet)

Name of Plugging Contractor Birmingham-Bartlett Drilling Co.  
Address 300 Kaufman Bldg., Wichita 2, Kansas

STATE OF Kansas, COUNTY OF Sedgwick, ss.  
Richard Hindery, partner of Birmingham-Bartlett Drilling Co., contractor of the above-described well, being first duly sworn on oath, says: That I have knowledge of the facts, statements, and matters herein contained and the log of the above-described well as filed and that the same are true and correct. So help me God. BIRMINGHAM-BARTLETT DRILLING CO.  
(Signature) By Richard Hindery Partner  
300 Kaufman Bldg., Wichita 2, Kansas (Address)

SUBSCRIBED AND SWORN to before me this 23rd day of April, 19 57  
My commission expires October 2, 1958.  
Beverly Hasso Notary Public.

RECEIVED  
STATE CORPORATION COMMISSION

PLUGGING  
FILE SEC 11 T. 22 R. 12w  
BOOK PAGE 7 LINE 26

APR 24 1957  
CONSERVATION DIVISION  
Wichita, Kansas

VOIGT NO. 1 WELL

LOCATION: SE/4 SW/4 SE/4  
Section 11-22S-12W  
Stafford County, Kansas

SPUDED: 4-10-57  
COMPLETED: 4-17-57

LEASE OWNER: Albert M. Austin  
522 Union National Building  
Wichita 2, Kansas

CONTRACTOR: Birmingham-Bartlett Drilling Co.  
300 Kaufman Building  
Wichita 2, Kansas

SURFACE CASING: 8-5/8" 28# used casing cemented at  
214' with 200 sacks cement and 4 c.c.

OIL STRING: None set. Dry and abandoned.  
Plugged 4-18-57.

LOG

(Figures indicate bottom of formation)

0	140	Sand and shale
	214	Shale and red bed
	460	Red bed and shells
	629	Red bed
	655	Anhydrite
	1400	Shale and shells
	2460	Shale and lime
	2750	Shale and shells
	3075	Lime and shale
	3265	Lime
	3300	Shale and lime
	3580	Lime
	3630	Chert and lime
	3660	Lime and shale
	3675	Arbuckle
	3685	Lime
	3685	Rotary Total Depth

The undersigned, Richard Hindery, one of the partners of Birmingham-Bartlett Drilling Co., hereby certifies that the above is a true and correct log of the formations encountered in drilling the Voigt No. 1 Well as shown in the daily drilling reports.

BIRMINGHAM-BARTLETT DRILLING CO.

By Richard Hindery

Subscribed and sworn to before  
me this 23rd day of April, 1957.

Beverly Larson

Notary Public

My commission expires October 2, 1958.

RECEIVED  
STATE CORPORATION COMMISSION

APR 24 1957

PLUGGING	CONSERVATION DIVISION
FILE SEC. 11 T. 22 R. 12W	Wichita, Kansas
BOOK PAGE 7	LINE 26