

STATE OF KANSAS  
STATE CORPORATION COMMISSION

WELL PLUGGING RECORD

Give All Information Completely  
Make Required Affidavit  
Mail or Deliver Report to:  
Conservation Division  
State Corporation Commission  
806 Bittling Building  
Wichita, Kansas

Stafford

County, Sec. 11 Twp. 22S Rge. 12 (E) E (W)

Location as "NE/CNW $\frac{1}{4}$ /SW $\frac{1}{4}$ " or footage from lines SW-SW-NW

Lease Owner Petroleum, Incorporated

Lease Name Obenhaus Well No. 1

Office Address 100 Derby Bldg., Wichita 2, Kansas

Character of Well (completed as Oil, Gas or Dry Hole) Oil

Date well completed July 8 1949

Application for plugging filed January 17 1952

Application for plugging approved February 4 1952

Plugging commenced January 26, 1952


Plugging completed February 4 1952

Reason for abandonment of well or producing formation

Depletion of producible zones

If a producing well is abandoned, date of last production November 12 1951

Was permission obtained from the Conservation Division or its agents before plugging was commenced? Yes

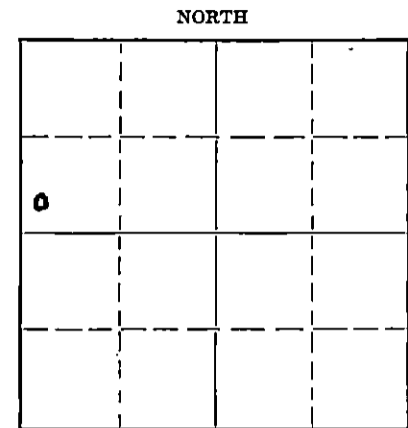

Locate well correctly on above Section Flat

Name of Conservation Agent who supervised plugging of this well C. D. Stough

Producing formation Arbuckle Depth to top 3633' Bottom 3663.5' Total Depth of Well 3663.5' Feet

Show depth and thickness of all water, oil and gas formations.

OIL, GAS OR WATER RECORDS

CASING RECORD

Formation	Content	From	To	Size	Put In	Pulled Out
Arbuckle	Oil & Water	3,633'	3,663.5'	8-5/8" OD	195'	none
Kansas City	Water	3,477'	3,485'	5" OD	3633'	2286'

Describe in detail the manner in which the well was plugged, indicating where the mud fluid was placed and the method or methods used in introducing it into the hole. If cement or other plugs were used, state the character of same and depth placed, from \_\_\_\_\_ feet to \_\_\_\_\_ feet for each plug set.

(Set Baker Cast Iron Plug at 3,510'.) Filled hole with sand up to 3,430', and placed 5 sacks cement on top of sand. Bailed hole. Pumped in 50 sacks of mud; and 75 sacks cement. Checked plug to 110'. Mudded hole to 20' and ran 5 sacks cement, filling surface pipe.

(If additional description is necessary, use BACK of this sheet)

Correspondence regarding this well should be addressed to Petroleum, Inc.  
Address Rural Route 2, Great Bend, Kansas

STATE OF Kansas, COUNTY OF Barton SEDGWICK, ss.  
Paul B. Shivel (employee of owner) or (owner or operator) of the above-described well,

being first duly sworn on oath, says: That I have knowledge of the facts, statements, and matters herein contained and the log of the above described well as filed and that the same are true and correct. So help me God.

(Signature) Paul B. Shivel

2-9-52

Route 2, Great Bend, Kansas


(Address)

SUBSCRIBED AND SWORN TO before me this 7th day of February 1952

Charlotte Keisman  
Notary Public.

My commission expires October 13, 1954

22-7377-9, 4-49-10M

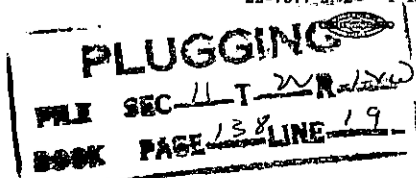

WELL LOG OBENHAUS NO. 1

Petroleum, Inc. - Lease Owners  
Rotary Total Depth - 3638'  
Commenced: June 18, 1949  
Completed: July 1, 1949  
Casing: 210' of 8 5/8"  
3635.5' of 5 1/2"

Sec. 11, Twp. 22S, Range 12W  
Location: SW SW NW  
County: Stafford County, Kansas  
Elevation: 1846 D.F.  
Production:

Figures below indicated bottom of formation.

30	Sand	3315	Shale & Lime
160	Sand, Shale & Shells	3555	Lime
190	Shale & Shells	3567	Viola
465	Red Bed	3630	Shale & Lime
645	Shells - Red Red	3634	Shale
675	Anhydrite	3638	Arbuckle
885	Lime & Shale		
1480	Shale & Shells	3638	ROTARY TOTAL DEPTH
2040	Lime & Shale		
2150	Broken Lime		
2300	Lime & Shale		
2565	Shale & Shells		
2850	Shale & Lime		
2880	Broken Lime		
3060	Lime & Shale		
3190	Lime		
3260	Shale		

I hereby certify that this is a true and correct log of the abovementioned Well.

PETROLEUM, INC.

*Eric H. Jager*  
Eric H. Jager

STATE OF KANSAS :  
                  : SS.  
SEDGWICK COUNTY :

FEB 9 X 1952  
CO. K

Subscribed and sworn to before me, a Notary Public in said County and State this 5th day of July 1949.

**PLUGGING**  
FILE SEC 11 T 22 R 12  
BOOK PAGE 138 LINE 19

*Rowland Koch*  
Notary Public

My Commission expires: June 7, 1952.