

STATE OF KANSAS
STATE CORPORATION COMMISSION

WELL PLUGGING RECORD

Give All Information Completely
Make Required Affidavit
Mail or Deliver Report to:
Conservation Division
State Corporation Commission
800 Bitting Building
Wichita, Kansas

OR


FORMATION PLUGGING RECORD

Strike out upper line
when reporting plug-
ging off formations.

Stafford

County Sec. 11 Twp. 22 Rge. (E) 12 (W)

Location as "NE 1/4 NW 1/4 SW 1/4" or footage from lines C-11 1/2 NW 1/4 NE 1/4
Lease Owner W. Paulkner
Lease Name Hullman Well No. 1
Office Address 409 First North Blvd. Wichita, Ks.
Character of Well (completed as Oil, Gas or Dry Hole) Dry
Date well completed Nov 13 1944
Application for plugging filed March 30 1946
Application for plugging approved 19
Plugging commenced 19
Plugging completed 19
Reason for abandonment of well or producing formation Dry

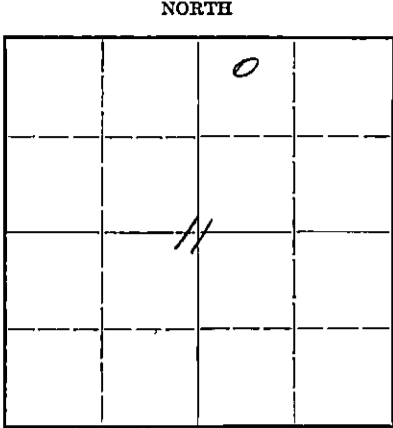

Locate well correctly on above
Section Plat

If a producing well is abandoned, date of last production Never produced
Was permission obtained from the Conservation Division or its agents before plugging was com-
menced? March 30 - 1946

Name of Conservation Agent who supervised plugging of this well
Producing formation Caribuckler Depth to top Bottom 3743 Total Depth of Well 3743 Feet
Show depth and thickness of all water, oil and gas formations.

OIL, GAS OR WATER RECORDS

CASING RECORD

Formation	Content	From	To	Size	Put In	Pulled Out
<u>Surface pipe</u>	<u>cement circulated</u>	<u>0</u>	<u>280</u>	<u>8 5/8</u>	<u>280</u>	<u>0</u>

Describe in detail the manner in which the well was plugged, indicating where the mud fluid was placed and the method or methods used in introducing it into the hole. If cement or other plugs were used, state the character of same and depth placed, from _____ feet to _____ feet for each plug set.

FROM 3743' to 3707' - 6 SACKS CEMENT
FROM 3707' TO 250' - MUD
FROM 250' TO 248' - 2' WOOD SILL BRIDGE
FROM 248' TO 188' - 20 SACKS CEMENT
FROM 188' TO 15' - BASE CELLAR - SURFACE DIRT
FROM 15' TO 3' - 10 SACKS CEMENT
FROM 3' TO 0' - CELLAR
WELL COMPLETED

STANDARD CASING PULLING Co

11 22 12W BY R. L. Glasgow
50 14

(If additional description is necessary, use BACK of this sheet)

Correspondence regarding this well should be addressed to
Address

STATE OF Kansas, COUNTY OF Sedgwick
W. O. Paulkner (employer of owner) or (owner or operator) of the above-described well,

being first duly sworn on oath, says: That I have knowledge of the facts, statements, and matters herein contained and the log of the above-described well as filed and that the same are true and correct. So help me God.

(Signature) W. O. Paulkner
409 First North Blvd. Wichita

SUBSCRIBED AND SWORN to before me this 30 day of March 1946

My commission expires Jan 14, 1948

Notary Public stamp for Elmer Russell, dated 9-12-46. The stamp includes a circular seal and the text "Notary Public".

WELL LOG

Company: W. P. Faulkner
 Lease: Hullmann #1
 County: Stafford
 Driller: Campbell & Kuhn
 Well Commenced: October 26, 1944
 Well Finished: November 13, 1944

<u>From</u>	<u>To</u>	
0	8	Cellar
8	195	Sand
195	245	Sand
245	273	Red Rock
273	420	Red Bed
420	725	Red Bed
725	753	Anhydrite
753	770	Shale
770	932	Shale
932	1240	Shale
1240	1325	Shale
1325	1525	Lime & Shale
1525	1642	Shale & Lime
1642	1675	Shale & Shell
1675	1740	Anhydrite
1740	1675	Shale & Shell
1765	1780	Lime & Shale
1780	1810	Chirty Lime
1810	1835	Lime & Shale
1835	1943	Lime & Shale
1943	2045	Shale & Lime
2045	2108	Shale
2108	2192	Shale & Lime
2192	2279	Shale & Shell
2279	2310	Lime
2310	2392	Lime & Shale
2392	2490	Shale & Lime
2490	2555	Lime & Shale
2555	2619	Lime & Shale
2619	2674	Shale & Lime
2674	2745	Shale & Lime
2745	2802	Lime & Shale
2802	2869	Shale & Lime
2869	2938	Shale & Lime
2938	2976	Lime & Shale
2976	3017	Shale & Lime
3017	3065	Lime & Shale
3065	3130	Lime & Shale
3130	3174	Lime
3174	3206	Lime
3206	3246	Lime
3246	3294	Lime
3294	3343	Shale
3343	3369	Shale
3369	3375	Lime
3375	3420	Lime
3420	3465	Shale & Lime
3465	3508	Lime & Shale
3508	3536	Shale & Lime
3536	3583	Shale & Lime
3583	3602	Lime
3602	3615	Shale
3615	3647	Shale-Some Chirt
3647	3660	Shale & Lime
3660	3669	Chirt
3669	3690	Chirt
3690	3701	Lime & Shale
3701	3731	Shale
3731	3740	Shale
3740	3743	Dolemite
3743	3748	T. D. Arbuckle

11 22 12W
50 14

SEP 12 1946