


STATE OF KANSAS  
STATE CORPORATION COMMISSION

Form CP-4

Give All Information Completely  
Make Required Affidavit  
Mail or Deliver Report to:  
Conservation Division  
State Corporation Commission  
212 No. Market  
Wichita, Kansas

WELL PLUGGING RECORD

Stafford County. Sec. 12 Twp. 22S Rge. (E) 12 (W)  
Location as "NE/CNW/SW" or footage from lines SW SW SW  
Lease Owner Circle Oil Company, Inc.  
Lease Name VOIGT Well No. 1  
Office Address 500 Bitting Building, Wichita, Kansas  
Character of Well (completed as Oil, Gas or Dry Hole) Dry Hole  
Date well completed March 30, 19 67  
Application for plugging filed 19  
Application for plugging approved 19  
Plugging commenced March 30, 19 67  
Plugging completed March 30, 19 67  
Reason for abandonment of well or producing formation Dry Hole

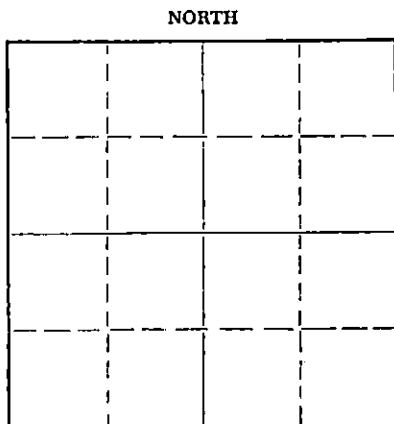

Locate well correctly on above Section Plat

If a producing well is abandoned, date of last production 19  
Was permission obtained from the Conservation Division or its agents before plugging was commenced? Yes (Archie Elving)

Name of Conservation Agent who supervised plugging of this well  
Producing formation Depth to top Bottom Total Depth of Well 3649 Feet  
Show depth and thickness of all water, oil and gas formations.

OIL, GAS OR WATER RECORDS

CASING RECORD

FORMATION	CONTENT	FROM	TO	SIZE	PUT IN	PULLED OUT
	Surface	0	234'	8-5/8"	3/23/67	-----
	Casing					

Describe in detail the manner in which the well was plugged, indicating where the mud fluid was placed and the method or methods used in introducing it into the hole. If cement or other plugs were used, state the character of same and depth placed, from feet to feet for each plug set.

Heavy Mud from Total Depth to 200 Feet;  
1/2 sack Hulls Plug and 25 sacks Cement thru the Drill Pipe; Heavy Mud to 40 Feet;  
1/2 sack Hulls Plug and 10 sacks Cement to Base of Cellar; 2 sacks Cement in Rat Hole.  
Job Completed at 12:45 P.M.

RECEIVED  
STATE CORPORATION COMMISSION

APR 4 1967

CONSERVATION DIVISION  
Wichita, Kansas

(If additional description is necessary, use BACK of this sheet)

Name of Plugging Contractor Sage Drilling Co.  
Address 500 Bitting Building, Wichita, Kansas 67202

STATE OF KANSAS, COUNTY OF SEDGWICK, ss.  
Lawrence F. Gray (employee of owner) or (owner or operator) of the above-described well, being first duly sworn on oath, says: That I have knowledge of the facts, statements, and matters herein contained and the log of the above-described well as filed and that the same are true and correct. So help me God.

(Signature) Lawrence F. Gray  
500 Bitting Building, Wichita, Kansas  
(Address)

SUBSCRIBED AND SWORN TO before me this 3rd day of April, 1967

Louise K. Whitted  
Louise K. Whitted - Notary Public.

My commission expires November 26, 1970

DRILLERS LOG

VOIGT NO. 1

CASING RECORD:	COMPANY: Circle Oil Co.	DESCRIPTION:
8-5/8" @ 234' w/200 sax cement	CONTRACTOR: Sage Drilling Co.	SW SW SW Sec. 12-22S-12W Stafford County, Kansas
TOTAL DEPTH: 3649'	COMMENCED: March 23, 1967	ELEVATION: 1842KB
	COMPLETED: March 30, 1967	

<u>FORMATION</u>	<u>FROM</u>	<u>TO</u>	<u>REMARKS</u>
Surface Soil	0	235	
Red Bed	235	608	
Anhydrite	608	628	
Shale	628	750	
Shale & Lime	750	1773	
Lime & Shale	1773	1995	
Shale & Lime	1995	2838	
Lime & Shale	2838	3215	
Shale	3215	3247	
Lime & Shale	3247	3537	
Lime	3537	3538	
Chert & Lime	3538	3584	
Lime & Shale	3584	3649	

**RECEIVED**  
 STATE SURVEY COMMISSION  
 APR 4 1967  
 CONSERVATION DIVISION  
 Wichita, Kansas

I certify that this is a true and correct copy of the above log to the best of my knowledge.

SAGE DRILLING CO., INC.

By Lawrence F. Gray  
 Lawrence F. Gray

Subscribed and sworn to before me this 3rd day of April, 1967.

Louise K. Whitted  
 Louise K. Whitted, Notary Public

My Commission expires:  
 November 26, 1970.