


WELL PLUGGING RECORD

Give All Information Completely
Map Required Affidavit
Mail or Deliver Report to:
Conservation Division
State Corporation Commission
800 Bitting Building
Wichita, Kansas

NORTH

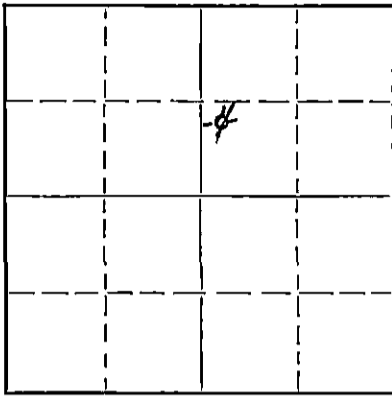

Locate well correctly on above
Section Flat

Stafford County. Sec. 12 Twp. 22S Rge. 12W (E).....(W)
Location as "NE/CNW $\frac{1}{4}$ /SW $\frac{1}{4}$ " or footage from lines NW $\frac{1}{4}$ SW $\frac{1}{4}$ NE $\frac{1}{4}$
Lease Owner Birmingham-Bartlett Drilling Co.
Lease Name Willinger Well No. 2
Office Address 300 Kaufman Building, Wichita 2, Kansas
Character of Well (completed as Oil, Gas or Dry Hole) Dry Hole
Date well completed ~~January 25~~ 10-17-52
Application for plugging filed January 25 19 52
Application for plugging approved January 29 19 52
Plugging commenced ~~January 2-18~~ 19 52
Plugging completed ~~January 2-20~~ 19 52
Reason for abandonment of well or producing formation Dry Hole

If a producing well is abandoned, date of last production Dry hole 19
Was permission obtained from the Conservation Division or its agents before plugging was commenced? Yes

Name of Conservation Agent who supervised plugging of this well C. D. Stough
Producing formation Arbuckle Depth to top 3626 Bottom 3637 Total Depth of Well 3637 Feet
Show depth and thickness of all water, oil and gas formations.

OIL, GAS OR WATER RECORDS

CASING RECORD

Formation	Content	From	To	Size	Put In	Pulled Out
		0	194'	8-5/8"	194'	None
		0	3627'	5-1/2"	3627'	3211', 89"

Describe in detail the manner in which the well was plugged, indicating where the mud fluid was placed and the method or methods used in introducing it into the hole. If cement or other plugs were used, state the character of same and depth placed, from.....feet to.....feet for each plug set.

Filled hole with sand from 3637' up to 3600', then dumped 5 sks. of Cement filling casing up to 3560'. then mudded hole up to 195', then spotted rock bridge, then dumped 15 sks. of cement, filling 8 5/8" csg up to 160' then mudded casing up to 30'. then dumped 10 sks. of cement filled surface up to base of cellar.

2-26-52

REGISTERED
STATE OF KANSAS

(If additional description is necessary, use BACK of this sheet)
Correspondence regarding this well should be addressed to Birmingham-Bartlett Drilling Co.
Address 300 Kaufman Building, Wichita 2, Kansas

STATE OF KANSAS COUNTY OF SEDGWICK
Richard Hindery, partner of Birmingham-Bartlett Drilling Co., owner and operator,
(employee of owner) or (owner or operator) of the above-described well,
being first duly sworn on oath, says: That I have knowledge of the facts, statements, and matters herein contained and the log of the above-described well as filed and that the same are true and correct. So help me God.

(Signature) Richard Hindery
300 Kaufman Building, Wichita 2, Kansas
(Address)

SUBSCRIBED AND SWORN TO before me this 25th day of February, 19 52

W. L. Zinger
Notary Public.

My commission expires November 29, 1954

PLUGGING
FILE SEC 12 TWP 22S R 12W
PAGE 14 LINE 20

WILLINGER NO. 2 WELL

LOCATION: NW $\frac{1}{4}$ SW $\frac{1}{4}$ NE $\frac{1}{4}$ Sec. 12-22S-12W
Stafford County, Kansas

SPUDED: 9-29-51

OPERATOR: Birmingham-Bartlett Drilling Co.

COMPLETED: 10-9-51

CONTRACTOR: Same

SURFACE CASING: Ran 8-5/8" 24# casing cemented at 194'
with 170 sacks cement and 2 c.c.

OIL STRING: 5 $\frac{1}{2}$ " 14# J-55 casing cemented at 3627'
with 60 sacks cement.

L O G

(Figures indicate bottom of formation)

0 to	80	Sand and clay
	194	Red bed and shells
	230	Shale and shells
	590	Red bed
	610	Anhydrite
	1590	Shale and shells
	1755	Broken lime
	1910	Lime
	2035	Lime and shale
	2935	Shale and shells
	3027	Shale and lime
	3440	Lime
	3490	Lime and shale
	3550	Cherty conglomerate
	3592	Cherty lime
	3611	Lime and shale
	3626	Shale
	3628	Arbuckle
	3628	Total depth

The undersigned Richard Hindery of the Birmingham-Bartlett Drilling Co. hereby certifies that the above is a true and correct log of the formations encountered in drilling the Willinger #2 well as shown on the daily drilling reports.

BIRMINGHAM-BARTLETT DRILLING CO.

BY Richard Hindery

Subscribed and sworn before me
this 12th day of October, 1951.

William L. Grogan
Notary Public

My commission expires November 29, 1954.

