

STATE CORPORATION COMMISSION OF KANSAS
OIL & GAS CONSERVATION DIVISION

WELL COMPLETION OR RECOMPLETION FORM
ACO-1 WELL HISTORY

DESCRIPTION OF WELL AND LEASE

Operator: License # 9247
Name Cincris Energy Company, Inc.
Address 625 S. Washington
City/State/Zip Great Bend, Ks. 67530

Purchaser: NA

Operator Contact Person William V. Riley
Phone 316-792-8278

Contractor: License # 4087
Name Williamson Drilling Inc.

Wellsite Geologist Steve Murphy
Phone 316-262-7397

Designate Type of Completion
 New Well Re-Entry Workover
 Oil SWD Temp Abd
 Gas Inj Delayed Comp.
 Dry Other (Core, Water Supply etc.)

If OWWO: old well info as follows:
Operator
Well Name
Comp. Date Old Total Depth

WELL HISTORY

Drilling Method:
 Mud Rotary Air Rotary Cable
1-8-85 1-12-85 1-13-85
Spud Date Date Reached TD Completion Date
3910' PBDT
Total Depth

Amount of Surface Pipe Set and Cemented at 305 feet
Multiple Stage Cementing Collar Used? Yes No
If yes, show depth set feet
If alternate 2 completion, cement circulated from feet depth to w/ SX cmt

API NO. 15-185-22,158-0600
County Stafford
S/2 NW SE Sec. 6 Twp 23 Rge. 13 East West

1650 Ft North from Southeast Corner of Section
1980 Ft West from Southeast Corner of Section
(Note: Locate well in section plat below)


Lease Name Corn Well # 1

Field Name WILDHORSE

Producing Formation LKC, ARB

Elevation: Ground 1913 KB 1918

Section Plat

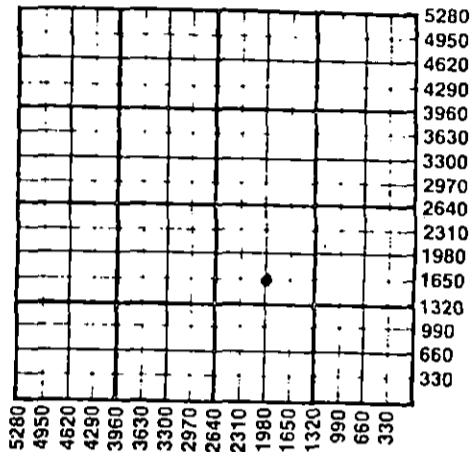

WATER SUPPLY INFORMATION

Disposition of Produced Water: Disposal Repressuring
Docket #

Questions on this portion of the ACO-1 call:
Water Resources Board (913) 296-3717

Source of Water:
Division of Water Resources Permit #

Groundwater 1650 Ft North from Southeast Corner (Well) 1980 Ft West from Southeast Corner of S/2 NW SE Sec 6 Twp 23 Rge 13 East West

Surface Water Ft North from Southeast Corner (Stream, pond etc) Ft West from Southeast Corner Sec Twp Rge East West

Other (explain) (purchased from city, R.W.D. #)

INSTRUCTIONS: This form shall be completed in duplicate and filed with the Kansas Corporation Commission, 200 Colorado Derby Building, Wichita, Kansas 67202, within 90 days after completion or recompletion of any well. Rule 82-3-130 and 82-3-107 apply. Information on side two of this form will be held confidential for a period of 12 months if requested in writing and submitted with the form. See rule 82-3-107 for confidentiality in excess of 12 months. One copy of all wireline logs and drillers time log shall be attached with this form. Submit CP-4 form with all plugged wells. Submit CP-111 form with all temporarily abandoned wells.

All requirements of the statutes, rules and regulations promulgated to regulate the oil and gas industry have been fully complied with and the statements herein are complete and correct to the best of my knowledge.

Signature William V. Riley

Title President Date 3-11-85

Subscribed and sworn to before me this 14th day of March 1985

Notary Public Charlene M. Marker

Date Commission Expires 11-14-87

K.C.C. OFFICE USE ONLY
 Letter of Confidentiality Attached
 Wireline Log Received
 Drillers Timelog Received
Distribution
 KCC SWD/Rep NGPA
 KGS Plug Other (Specify)

RECEIVED STATE CORPORATION COMMISSION

Form ACO-1 (7-84)

Charlene M. Marker
NOTARY PUBLIC
State of Kansas
MY APPT. EXPIRES 11-14-87

MAR 15 1985 3-15-85

CONSERVATION DIVISION
Wichita, Kansas

Sec 6 Twp 23 Rge 13W



tests g...
pressure...
If gas to...

Dr. ... [X] No
S... [] No
C... [] No

Form with sections: Purpos, Shot, TUBING, Date of, Eff. Date of Production. Includes checkboxes for 'No' and 'Yes' and various data entry fields.

Disposition of gas: [] vented, [] ...
[] ...
[] ...