

RECEIVED  
STATE CORPORATION COMMISSION  
JAN 17 1972  
CONSERVATION DIVISION Form CP-4  
Wichita, Kansas

STATE OF KANSAS  
STATE CORPORATION COMMISSION


WELL PLUGGING RECORD

Give All Information Completely  
Make Required Affidavit  
Mail or Deliver Report to:  
Conservation Division  
State Corporation Commission  
212 No. Market  
Wichita, Kansas

Stafford County, Sec. 2 Twp. 22 Rge. 12 (E) (W)

Location as "NE/CNWSW" or footage from lines. C W/2 SE NW  
Lease Owner Clinton Oil Company  
Lease Name Hitz #2 Well No. \_\_\_\_\_  
Office Address Great Bend, Kansas 67530  
Character of Well (completed as Oil, Gas or Dry Hole) Oil  
Date well completed 11/25/39 19\_\_\_\_  
Application for plugging filed 12/7/71 19\_\_\_\_  
Application for plugging approved 12/9/71 19\_\_\_\_  
Plugging commenced 1/3/72 19\_\_\_\_  
Plugging completed 1/7/72 19\_\_\_\_  
Reason for abandonment of well or producing formation depleted.

NORTH

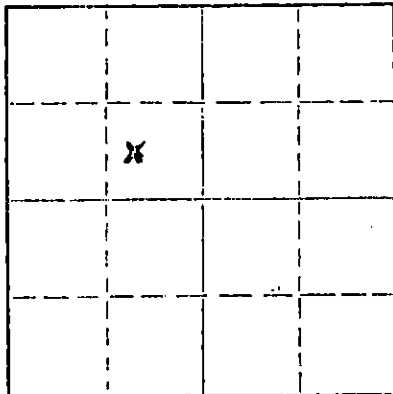

Locate well correctly on above  
Section Plat

If a producing well is abandoned, date of last production June 1970  
Was permission obtained from the Conservation Division or its agents before plugging was commenced? yes

Name of Conservation Agent who supervised plugging of this well Biberstein  
Producing formation Lansing Depth to top 3235' Bottom 3426' Total Depth of Well 3571 Feet  
Show depth and thickness of all water, oil and gas formations.

OIL, GAS OR WATER RECORDS

CASING RECORD

FORMATION	CONTENT	FROM	TO	SIZE	PUT IN	PULLED OUT
Arbuckle	Oil	3566'	3571'	8-5/8"	237	none
Lansing	Oil	3224'	3566'	5 1/2"	3566	1983'

Describe in detail the manner in which the well was plugged, indicating where the mud fluid was placed and the method or methods used in introducing it into the hole. If cement or other plugs were used, state the character of same and depth placed, from \_\_\_\_\_ feet to \_\_\_\_\_ feet for each plug set.

Checked hole to 3510', pushed plug to 3200' and ran 5 sacks of cement. Shot pipe at 3003', 2797', 2508', 1995', pulled 63 joints. Bailed hole to 225', set rock bridge and ran 4 yards concrete. Talled pipe.

PLUGGING COMPLETE.

(If additional description is necessary, use BACK of this sheet)  
KNIGHT CASING PULLING CO., INC.

Name of Plugging Contractor CHASE, KANSAS  
Address \_\_\_\_\_

STATE OF KANSAS COUNTY OF RICE, ss.  
NOEL J. KNIGHT (employee of owner) or (owner or operator) of the above-described well, being first duly sworn on oath, says: That I have knowledge of the facts, statements, and matters herein contained and the log of the above-described well as filed and that the same are true and correct. So help me God.

(Signature) Noel Knight  
CHASE, KANSAS (Address)

MARGARET MELCHER  
SUBSCRIBED AND SWORN TO  
Rice County, Kansas  
My Commission Expires  
Feb. 15, 1975



10th day of January, 1972  
Margaret Melcher  
Notary Public.