


STATE OF KANSAS
STATE CORPORATION COMMISSION

Give All Information Completely
Make Required Affidavit
Mail or Deliver Report to:
Conservation Division
State Corporation Commission
800 Bitting Building
Wichita, Kansas

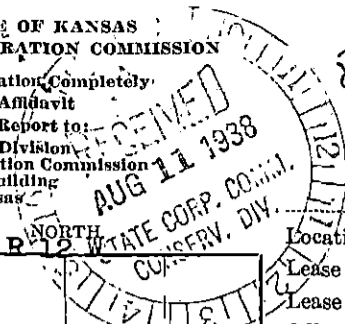

WELL PLUGGING RECORD
OR
FORMATION PLUGGING RECORD

Strike out upper line
when reporting plug-
ging off formations.

8-11-38

Stafford County. Sec. 2 Twp. 22 Rge. (E) 12 (W)

Location as "NE 1/4 NW 1/4 SW 1/4" or footage from lines NW 1/4 - SW 1/4 - NW 1/4

Lease Owner Stanolind Oil and Gas Company

Lease Name F. Hitz Well No. 1

Office Address Box 591, Tulsa, Oklahoma

Character of Well (Completed as Oil, Gas or Dry Hole) Dry Hole

Date, well completed June 27 1938

Application for plugging filed June 27 1938

Application for plugging approved June 27 1938


Plugging Commenced June 28 1938

Plugging Completed June 29 1938

Reason for abandonment of well or producing formation Non-producing

If a producing well is abandoned, date of last production 1938

Was permission obtained from the Conservation Division or its agents before plugging was commenced? Yes

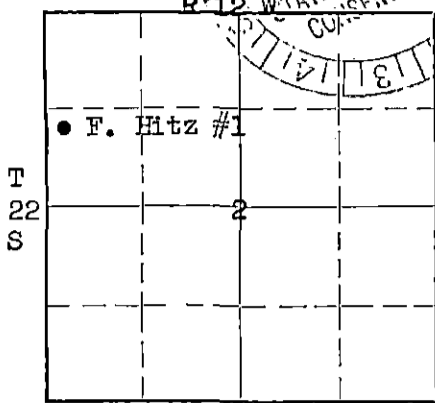

Locate well correctly on above
Section Plat

Name of Conservation Agent who supervised plugging of this well Ed Sheil

Producing formation Siliceous Depth to top 3610 Bottom 3631 Total Depth of Well 3631 Feet.

Show depth and thickness of all water, oil and gas formations.

OIL, GAS OR WATER RECORDS


CASING RECORD

Formation	Content	From	To	Size	Put In	Pulled Out
Viola	Dry	3540		10 3/4" OD	286' (Thds. off)	None
Simpson	"	3540		6" OD	3605' 13" ("	") "
Siliceous	Water	3610	3631			

Describe in detail the manner in which the well was plugged, indicating where the mud fluid was placed and the method or methods used in introducing it into the hole. If cement or other plugs were used, state the character of same and depth placed, from _____ feet to _____ feet for each plug set.

3631 - 3567 Cement
3567 - 3417 Heavy Mud
Wood plug in top of 6" casing.

Temporarily Abandoned

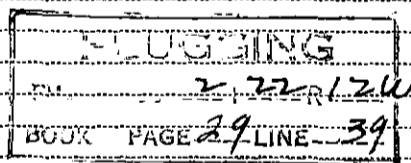

(If additional description is necessary, use BACK of this sheet)

Correspondence regarding this well should be addressed to Stanolind Oil and Gas Company

Address Box 591, Tulsa, Oklahoma.

STATE OF Kansas, COUNTY OF Barton, ss.

H. G. Nething (employee of owner) or (owner or operator) of the above-described well, being first duly sworn on oath, says: That I have knowledge of the facts, statements, and matters herein contained and the log of the above-described well as filed and that the same are true and correct. So help me God.

(Signature) H. G. Nething

(Address) Ellinwood Kansas


SUBSCRIBED AND SWORN TO before me this 8th day of August, 1938

My commission expires May 3, 1941

640 Acres

STANOLIND OIL AND GAS COMPANY

WELL RECORD

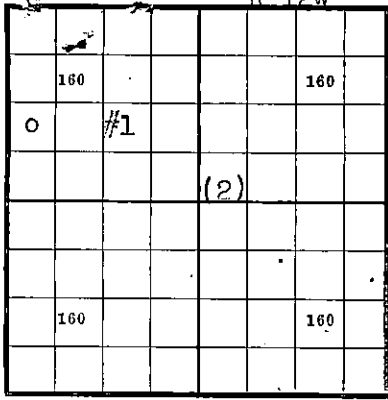

Locate Well Correctly

COUNTY Stafford, SEC. 2, TWP. 22s, RGE. 12W
 COMPANY OPERATING Stanolind Oil and Gas Company
 OFFICE ADDRESS Box 591 - Tulsa, Oklahoma
 FARM NAME F. Hitz WELL NO. 1
 DRILLING STARTED May 29, 1938, DRILLING FINISHED June 25, 1938
 WELL LOCATED NW 1/4 SW 1/4 NW 1/4 990 ft. North of South
 Line and 330 ft. East of West Line of Quarter Section.
 ELEVATION (Relative to sea level) DERRICK FLR. 1835 GROUND 1832
 CHARACTER OF WELL (Oil, gas or dry hole) Dry hole

OIL OR GAS SANDS OR ZONES

Name	From	To	Name	From	To
1 Lansing	3280		4 Siliceous	3610	3631
2 Viola	3540		5		
3 Simpson	3560		6		

WATER SANDS

Name	From	To	Water Level	Name	From	To	Water Level
1				4			
2				5			
3				6			

CASING RECORD

Size	Wt.	Thds.	Make	Amount Set		Amount Pulled		Packer Record			
				Ft.	In.	Ft.	In.	Size	Length	Depth Set	Make
10 1/2" OD	35.75	8	Beth'lm	286		(Threads off - landed 291' 8")					
6" OD	20#	10	Nat'1	3605	3	(Threads off - landed 3609' 8")					

Liner Record: Amount _____ Kind _____ Top _____ Bottom _____

CEMENTING AND MUDDING RECORD

Size	Amount Set		Sacks Cement	Chemical		Method Cementing	Amount	Mudding Method	Results (See Note)
	Feet	In.		Gal.	Make				
10 1/2" OD	289	8	250	Oilmax	Halliburton				
6" OD	3630		100	Oilmax	Halliburton				

PLUGGING

NOTE: What method was used to protect sands when outer strings were pulled? _____

NOTE: Were bottom hole plugs used? _____ If so, state kind, depth set and results obtained _____

TOOLS USED

Rotary tools were used from 0 feet to 3614 feet, and from _____ feet to _____ feet.
 Cable tools were used from 3614 feet to 3631 feet, and from _____ feet to _____ feet.
 Type Rig 94' steel

PRODUCTION DATA

Swabbed 3 barrels oil, trace of water per hour - June 19, 1938
 Production first 24 hours _____ bbls. Gravity _____, Emulsion _____ per cent., Water _____ per cent.
 Swabbed 2 1/2 barrels oil, 18 barrels water per hour - June 26, 1938
 Production second 24 hours _____ bbls. Gravity _____, Emulsion _____ per cent., Water _____ per cent.

If gas well, cubic feet per 24 hours _____ Rock Pressure, lbs. per square inch _____

I, the undersigned, being first duly sworn upon oath, state that this well record is true, correct and complete according to the records of this office and to the best of my knowledge and belief.

Paul Foreman
Name and Title

Subscribed and sworn to before me this the 16th day of July, 1938
 My commission expires May 3, 1941
Jean A. Wilcox
Notary Public.

FORMATION RECORD

Give detailed description and thickness of all formations drilled through and contents of sand, whether dry, water, oil or gas.

Formation	Top	Bottom	Formation	Top	Bottom
Surface soil and sand	0	120	Soft gray lime, slight porosity, no saturation.		
Shale and red rock	120	293	Swabbed two barrels oil one barrel water per hr.		
Red rock, shale, shells	293	400			
Shale and shells	400	585	<u>Core #3</u> - 2/2' recovery	3623	3625
Anhydrite	585	645			
Shale and shells	645	1348	Brown sandy lime, slight porosity, slight show oil.		
Salt	1348	1450			
Lime	1450	1480	<u>Core #4</u> - 1 1/2' recovery	3625	3627
Shale and shells	1480	1561			
Broken lime	1561	2909	Hard gray lime, slight show dead oil, slight porosity.		
Lime	2909	2947	Tested 2 barrels oil, 1 1/4 barrels water one hour.		
Broken lime	2947	2993			
Lime	2993	3185	<u>Core #5</u> - 2/2' recovery	3627	3629
Shale	3185	3189			
Shale and shells	3189	3250	Various colored lime and chert layers of green shale, some porosity, no saturation.		
Lime	3250	3495			
<u>Top Lansing</u>	3280		<u>Core #6</u> - 2/2' recovery	3629	3631
Broken lime	3495	3526			
Chert	3526	3547	Gray sandy lime, fair porosity, odor of sulphur		
Shale	3547	3561	Swabbed 18 barrels water, 2 1/4 oil 2 hours.		
Lime	3561	3587	8 sacks cement	3631	3617
Shale	3587	3598	Dumped 25 sacks Portland cement to abandon 6-28-38.		
Shale and lime	3598	3610	<u>Total Depth</u>	3631	
<u>Top Siliceous</u>	3610				
<u>Core #1</u> - 1 1/2' recovery	3610	3614	Date first work 5-24-38		
Dolomite, tan, sugary, sandy 6" good saturation and porosity			Date spudded 5-29-38		
<u>Top Viola</u>	3540		Date drilling completed 6-25-38		
<u>Top Simpson</u>	3560		Date completed as dry hole 6-27-38		
<u>Cable tools</u>			Temporarily plugged and abd. 6-29-38		
<u>Core #1</u> 1 1/2' Recovery	3614	3616			
Gray to white chert	3614	3615			
Brown sugary lime	3615	3615 1/2			
Dolomite, fair porosity, very little saturation	3615 1/2	3616			
Steel line correction	3616	= 3620			
Not enough oil to swab					
<u>Acidizing record</u>					
300 gallons Dowell xx 6-18-38					
Swabbed 2 barrels oil 1/4 barrel water per hour.					
600 gallons Dowell xx 6-20-38					
Swabbed 5 barrel oil, 1/2 barrel water per hour.					
1100 gallons Dowell xxf 6-21-38					
Swabbed 2 1/4 barrels oil, 1 1/4 barrels water per hour.					
<u>Core #2</u> - 1 1/2' Recovery	3620	3623			