

STATE OF KANSAS
STATE CORPORATION COMMISSION

Form CP-4


Give All Information Completely
Make Required Affidavit
Mail or Deliver Report to:
Conservation Division
State Corporation Commission
211 No. Broadway
Wichita, Kansas

WELL PLUGGING RECORD

Stafford County, Sec. 2 Twp. 22 Rge. 12 (E) W (W)

Location as "NE/CNW&SW" or footage from lines. SE NW NE
Lease Owner Bea Drilling Co., Inc. et al
Lease Name Teichmann Well No. 2
Office Address Box 247, Ellinwood, Kansas 67526
Character of Well (completed as Oil, Gas or Dry Hole) Dry hole
Date well completed 4/29/65 19____
Application for plugging filed Verbally 4/28/65. Written 5/4/65
Application for plugging approved 4/30/65 19____
Plugging commenced Approx. 2 A.M. 4/29/65 19____
Plugging completed 6 A.M. 4/29/65 19____
Reason for abandonment of well or producing formation _____

NORTH

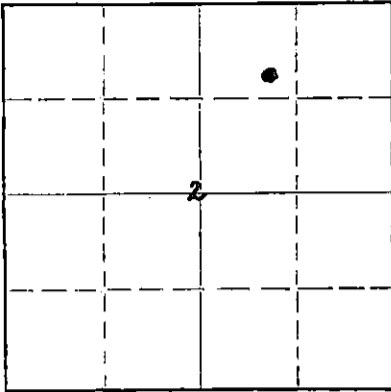

Locate well correctly on above
Section Plat

If a producing well is abandoned, date of last production _____ 19____
Was permission obtained from the Conservation Division or its agents before plugging was commenced? Yes

Name of Conservation Agent who supervised plugging of this well A. Elving
Producing formation _____ Depth to top _____ Bottom _____ Total Depth of Well 3642 Feet
Show depth and thickness of all water, oil and gas formations.

OIL, GAS OR WATER RECORDS

CASING RECORD

FORMATION	CONTENT	FROM	TO	SIZE	PUT IN	PULLED OUT
		0	271	8 5/8"	271	None

Describe in detail the manner in which the well was plugged, indicating where the mud fluid was placed and the method or methods used in introducing it into the hole. If cement or other plugs were used, state the character of same and depth placed, from _____ feet to _____ feet for each plug set.

Filled hole w/ heavy mud.
Set plug @240 ft, plus 1/2 sack hulls,
Run 25 sacks cement.
Set Plug @40 ft, plus 1/2 sack hulls,
Run 10 sacks cement, to base of cellar.

6-6-65

RECEIVED
STATE CORPORATION COMMISSION

MAY 6 1965

CONSERVATION DIVISION
Wichita, Kansas

(If additional description is necessary, use BACK of this sheet)

Name of Plugging Contractor Bea Drilling Co., Inc.
Address Box 247, Ellinwood, Kansas 67526

STATE OF Kansas, COUNTY OF Barton, ss.
C. F. Krehbiel (employee of owner) or (owner or operator) of the above-described

well, being first duly sworn on oath, says: That I have knowledge of the facts, statements, and matters herein contained and the log of the above-described well as filed and that the same are true and correct. So help me God.

(Signature) C. F. Krehbiel
Box 247, Ellinwood, Kansas
(Address)

SUBSCRIBED AND SWORN to before me this 4th day of May, 1965

My commission expires August 16, 1966
[Signature] Notary Public.



W E L L L O G

Teichmann #2
SE NW NE Sec. 2-22S-12W
Stafford County, Ks.

Operator: Bea Drilling Co., Inc.
Contractor: Bea Drilling Co., Inc.

Staked: 4/12/65
Started: 4/15/65
Rotary: 4/19/65
Completed: 4/29/65

Elevation: 1823 ft Gr. 1828 KB.

Casing Record:
Run 7 jts, 271.30 ft 20# 8v thd
8 5/8" casing, cemented w/165 sax
12 hr cement. Circulated. Plug down
7:30 P.M. 4/19/65. Job by Sun.

Tops:		
Topeka	2801	- 973
Heebner	3098	-1270
Toronto	3118	-1290
Douglas	3128	-1300
Brown lime	3226	-1398
Lansing-K.C.	3248	-1420
Viola	3506	-1614
Simpson	3566	-1738
Simpson sand	3602	-1774
Arbuckle	3635	-1807
Rotary T.D.	3642	-1814

Drill Stem Tests:

#1 3278 to 3328. Open 30 min, shut in 30 min. weak blow full hr.
recovered 45 ft mud, no oil. ICIP 122#; FCIP 98#; IFP 57#; FFP 65#.

#2 3436 to 3450. Open 30 min, shut in 30 min., open 30 min, shut
in 30 min, weak blow full hr. recovered 45 ft mud, very slightly oil
cut, and 300 ft of gas. ICIP 73#; FCIP 64#; IFP 26#; FFP 40#.

#3 3510 to 3538. Open 30 min, shut in 30 min, open 30 min, shut in
30 min, good blow, recovered 30 ft of mud, 1010 ft gas. ICIP 38#;
FCIP 107#; IFP 22#; FFP 30#.

#4 3612 to 3639. Tool would not go. 2nd try: 3612 to 3642-- test would
not go.

Drillers Log

(All measurements to bottom of formation.)

Surface soil, sand	100
Sand, shale	140
Shale	265
Red bed	610
Anhydrite	635
Shale & shells	1460
Shale & lime	2930
Lime & shale	3015
Lime	3070
Lime & Shale	3328
Lime	3406
Lime, chert	3538
Lime & shale	3639
Lime & chert	3642
Rotary total depth	3642

I hereby certify that the above is a true and correct log of said
well as reflected by the daily drilling, testing, and geological reports.

C. F. Krehbiel
C. F. Krehbiel, Vice-Pres.
Bea Drilling Co., Inc.

STATE OF KANSAS, COUNTY OF BARTON, ss

Subscribed and sworn to before me this 4th day of May, 1965.

[Signature]
Notary Public

My commission expires August 16, 1966

RECEIVED
STATE COMMISSIONER OF CONSERVATION

MAY 6 1965

CONSERVATION DIVISION
Wichita, Kansas