


WELL PLUGGING RECORD

Give All Information Completely  
Make Required Affidavit  
Mail or Deliver Report to:  
Conservation Division  
State Corporation Commission  
800 Bitting Building  
Wichita, Kansas

NORTH

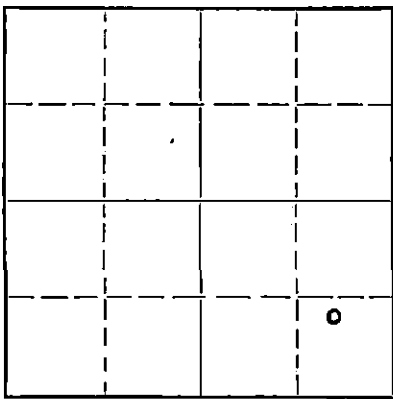

Locate well correctly on above Section Flat

Stafford County. Sec. 10 Twp. 22 Rge. 12 (E) W (W)  
Location as "NE/CNW $\frac{1}{4}$ SW $\frac{1}{4}$ " or footage from lines C N/2, SE/4, SE/4  
Lease Owner Stanolind Oil and Gas Company  
Lease Name K. Teichmann "A" Well No. 4  
Office Address P. O. Box 1654, Oklahoma City, Oklahoma  
Character of Well (completed as Oil, Gas or Dry Hole) Dry Hole  
Date well completed 11-21 19 51  
Application for plugging filed 11-30 19 51  
Application for plugging approved approval per C.D. Stough 11-21 19 51  
Plugging commenced 11-22 19 51  
Plugging completed 11-22 19 51  
Reason for abandonment of well or producing formation dry hole

If a producing well is abandoned, date of last production 19  
Was permission obtained from the Conservation Division or its agents before plugging was commenced? Yes

Name of Conservation Agent who supervised plugging of this well C. D. Stough  
Producing formation None Depth to top Bottom Total Depth of Well Feet  
Show depth and thickness of all water, oil and gas formations.

OIL, GAS OR WATER RECORDS

CASING RECORD

Formation	Content	From	To	Size	Put In	Pulled Out
Lansing	Dry	3292	3571			
Arbuckle	Dry	3746	3893			

Describe in detail the manner in which the well was plugged, indicating where the mud fluid was placed and the method or methods used in introducing it into the hole. If cement or other plugs were used, state the character of same and depth placed, from feet to feet for each plug set.

Hvy. rotary mud 3893 - 270  
set plug 270 - 268  
15 sx cement 268 - 224  
hvy. mud 224 - 30  
set plug 30 - 28  
10 sx cement 28 - to bottom of cellar

12-451

RECORDED  
STATE COMMISSION  
DEC - 4 1951  
CONSERVATION DIVISION  
Wichita, Kansas

(If additional description is necessary, use BACK of this sheet)

Name of Plugging Contractor  
Address

STATE OF Kansas, COUNTY OF Barton, ss.  
G. A. Younie (employee of owner) or (owner or operator) of the above-described well,  
being first duly sworn on oath, says: That I have knowledge of the facts, statements, and matters herein contained and the log of the above-described well as filed and that the same are true and correct. So help me God.

(Signature) *G. A. Younie* Field Supt.  
(Address)

SUBSCRIBED AND SWORN to before me this 30th day of November, 19 51

*Lewis G. Sorenson*  
Notary Public.

My commission expires May 2, 1955

23-8390-3 6-51-20M  
FILE SEC 10 T 22 R 12  
PAGE 26 LINE 25

## FORMATION RECORD

DESCRIBE EACH FORMATION DRILLED. INDICATE THICKNESS, CONTENT AND WHETHER DRY, OR OIL, GAS, OR WATER BEARING.

FORMATION	TOP	BOTTOM	FORMATION	TOP	BOTTOM
Surface Sand	0	190			
Red bed, shale, shells	190	610			
Red shale	610	630			
Anhydrite	630	675			
Red bed, shale	675	875			
Shale, shells	875	1150			
Salt Shale	1150	1420			
Shale, lime	1420	1715			
Lime	1715	2045			
Lime shale	2045	2735			
Lime	2735	3147			
Top Hechinger	3147				
Lime, shale	3147	3292			
Top Lansing	3292				
Lime	3292	3523			
Lime, shale	3523	3571			
Top Viola	3571				
Lime, shale	3571	3617			
Top Simpson	3617				
Lime, shale	3617	3630			
Shale	3630	3644			
Red shale	3644	3663			
Shale	3663	3691			
Shale, chert	3691	3714			
Chert	3714	3746			
Top Arbuckle	3746				
Lime chert	3746	3770			
Cherty lime, no shows	3770	3893			
Ben Schlumberger Logs to TD					
Total Depth					
By Schlumberger		3893			
By Rotary Drill		3893			
Well plugged and abandoned November 22, 1951					
Arbuckle Formation @ TD		3893			

PLUGGING  
FILE SEC. 1-1-1 W. R. 124  
DATE 1/20/51

STANOLIND OIL AND GAS COMPANY

WELL RECORD

TWP. 22 S N OR S

SUPPLEMENTAL (ENTER "X" WHEN APPLICABLE)

Grid for well location with '10' in the center and '6' in the bottom right.

LEASE K. Teichmann "A" WELL NO. 4

LOCATION OF WELL: 990 FT. NORTH SOUTH OF THE 660 FT. NORTH SOUTH LINE AND

EAST WEST OF THE EAST WEST LINE OF THE 6 N/2 SE 1/4 SE 1/4

OF SECTION 10 TOWNSHIP 22 NORTH SOUTH, RANGE 12 EAST WEST

Stafford Kansas COUNTY STATE

ELEVATION: RDB - 1854

COMPLETED AS: OIL WELL GAS WELL WATER WELL DRY HOLE

DRILLING: COMMENCED 11-5 19 51 COMPLETED 11-21 19 51

LOCATE WELL CORRECTLY

OPERATING COMPANY Stanolind Oil and Gas Company ADDRESS Box 1654, Oklahoma City, Oklahoma

OIL OR GAS SANDS OR ZONES

Table with columns: NAME, FROM, TO, NAME, FROM, TO. Rows include Lansing and Arbuckle.

WATER SANDS

Table with columns: NAME, FROM, TO, WATER LEVEL, NAME, FROM, TO, WATER LEVEL. Rows 1 and 2.

CASING RECORD (OVERALL MEASUREMENT)

LINER-SCREEN RECORD

Tables for Casing and Liner-Screen records with columns for size, weight, description, quantity, etc.

PACKER RECORD

Table for Packer record with columns: SIZE, LENGTH, SET AT, MAKE AND TYPE.

CEMENTING RECORD

MUDDING RECORD (CABLE TOOLS)

Tables for Cementing and Mudding records with columns for size, where set, cement, method, final press, etc.

WHAT METHOD WAS USED TO PROTECT SANDS WHEN OUTER STRINGS WERE PULLED?

WERE BOTTOM HOLE PLUGS USED?

IF SO, STATE KIND, DEPTH SET, AND RESULTS OBTAINED

ROTARY TOOLS WERE USED FROM 0 FEET TO 3893 FEET, AND FROM FEET TO FEET

CABLE TOOLS WERE USED FROM FEET TO FEET, AND FROM FEET TO FEET

24-HOUR PRODUCTION OR POTENTIAL TEST dry hole

WATER BBLs.

IF GAS WELL, CUBIC FEET PER 24 HOURS SHUT-IN PRESSURE LBS. PER SQUARE IN.

I, THE UNDERSIGNED, BEING FIRST DULY SWORN UPON OATH, STATE THAT THIS WELL RECORD IS TRUE AND CORRECT ACCORDING TO THE RECORDS OF THIS OFFICE AND TO THE BEST OF MY KNOWLEDGE AND BELIEF.

SUBSCRIBED AND SWORN TO BEFORE ME THIS 30th DAY OF NOVEMBER 1955. Notary Public signature and name.