

STATE OF KANSAS
STATE CORPORATION COMMISSION


Form CP-4

Give All Information Completely
Make Required Affidavit
Mail or Deliver Report to:
Conservation Division
State Corporation Commission
212 No. Market
Wichita, Kansas 67202

WELL PLUGGING RECORD

Stafford County, Sec. 2 Twp. 225 Rge. (E) 12 (W)

Location as "NE/CNW/RSW" or footage from lines _____
Lease Owner Clinton Oil Company
Lease Name Hitz #8 Well No. _____
Office Address Great Bend, Kansas 67530
Character of Well (completed as Oil, Gas or Dry Hole) Dry
Date well completed 2-26-68 19_____
Application for plugging filed 12-7-71 19_____
Application for plugging approved 12-9-71 19_____
Plugging commenced 1/19/72 19_____
Plugging completed 1/25/72 19_____
Reason for abandonment of well or producing formation depleted.

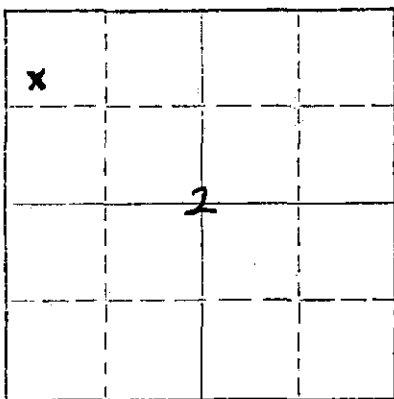

Locate well correctly on above
Section Plat

If a producing well is abandoned, date of last production _____ 19_____
Was permission obtained from the Conservation Division or its agents before plugging was commenced? yes

Name of Conservation Agent who supervised plugging of this well Biberstein
Producing formation L/KC Depth to top 3260' Bottom 3449' Total Depth of Well 3649' Feet
Show depth and thickness of all water, oil and gas formations.

OIL, GAS OR WATER RECORDS

CASING RECORD

FORMATION	CONTENT	FROM	TO	SIZE	PUT IN	PULLED OUT
				8-5/8"	616	none
				5 1/2"	3640	2236'

Describe in detail the manner in which the well was plugged, indicating where the mud fluid was placed and the method or methods used in introducing it into the hole. If cement or other plugs were used, state the character of same and depth placed, from _____ feet to _____ feet for each plug set.

Checked hole to 3486', pushed plug to 3225' and ran sand, ran 5 sacks of cement. Shot pipe at 2697', 2480', 2356', 2226', pulled 68 joints. Set 10' rock bridge at 240', ran 4 yards concrete. Talled pipe.

PLUGGING COMPLETE.

RECEIVED
STATE CORPORATION COMMISSION
FEB 2 1972
CONSERVATION DIVISION
Wichita, Kansas

(If additional description is necessary, use BACK of this sheet)

Name of Plugging Contractor KNIGHT CASING PULLING CO. INC.
Address CHASE, KANSAS

STATE OF KANSAS COUNTY OF RICE, ss.
NOEL J. KNIGHT (employee of owner) or (owner or operator) of the above-described well, being first duly sworn on oath, says: That I have knowledge of the facts, statements, and matters herein contained and the log of the above-described well as filed and that the same are true and correct. So help me God.

(Signature) Noel Knight
CHASE, KANSAS

(Address)

SUBSCRIBED AND SWORN TO before me this 26th day of January, 19 72

MARGARET MELCHER
NOTARY PUBLIC
Rice County, Kansas
My Commission Expires
Feb. 15, 1975

Margaret Melcher
Notary Public.

My commission expires