STATE OF KANSAS
STATE CORPORATION COMMISSION

Give All Information Completely
Make Required Affidavit
Mail or Deliver Report to:
Conservation Division
State Corporation Commission
800 Bitting Building
Wichita, Kansas

15-185-00089-0000

WELL PLUGGING RECORD

NORTH

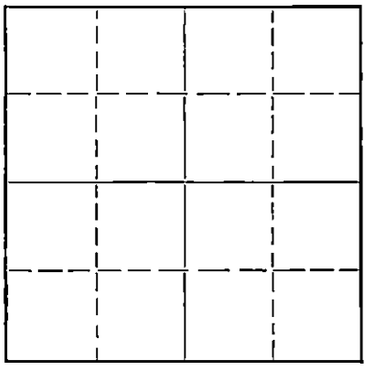

Locate well correctly on above Section Plat

Stafford County. Sec. 2 Twp. 23 Rge. 13 (E) (W)

Location as "NE/CNW¼SW¼" or footage from lines C W/2 NW/4 SE/4

Lease Owner Sterling Drilling Company et al

Lease Name Kelly Well No. 1

Office Address 304 N. Broadway, Sterling, Ks.

Character of Well (completed as Oil, Gas or Dry Hole) Dry Hole

Date well completed Dec. 1 19 52

Application for plugging filed Nov. 30 19 52

Application for plugging approved Nov. 30 19 52

Plugging commenced Dec. 1 19 52

Plugging completed Dec. 1 19 52

Reason for abandonment of well or producing formation Dry Hole

If a producing well is abandoned, date of last production 19

Was permission obtained from the Conservation Division or its agents before plugging was commenced? Yes.

Name of Conservation Agent who supervised plugging of this well M. A. Rives

Producing formation Depth to top Bottom Total Depth of Well 3896' Feet

Show depth and thickness of all water, oil and gas formations.

OIL, GAS OR WATER RECORDS

CASING RECORD

Formation	Content	From	To	Size	Put In	Pulled Out
				8-5/8"	316'	

RECEIVED
STATE CORPORATION COMMISSION
DEC - 4 1952
CONSERVATION DIVISION
Wichita, Kansas

12-4-52

Describe in detail the manner in which the well was plugged, indicating where the mud fluid was placed and the method or methods used in introducing it into the hole. If cement or other plugs were used, state the character of same and depth placed, from feet to feet for each plug set.

Filled hole with heavy mud. Laid down 2,000' pipe.
Filled hole again with heavy mud. Laid down rest
of drill pipe. Set wooden plug at 300'.
20 sacks cement through the drill pipe.
Set top plug at 35'. Cemented with 10 sacks.

(If additional description is necessary, use BACK of this sheet)

Name of Plugging Contractor Sterling Drilling Company

Address 304 N. Broadway, Sterling, Ks.

STATE OF Kansas, COUNTY OF Rice, ss.

Rollin Mead (employee of owner) or ~~(owner or operator)~~ of the above-described well, being first duly sworn on oath, says: That I have knowledge of the facts, statements, and matters herein contained and the log of the above-described well as filed and that the same are true and correct. So help me God.

(Signature) Rollin Mead

Sterling, Kansas
(Address)

SUBSCRIBED AND SWORN TO before me this 2nd day of December, 19 52

F. B. Meullner
Notary Public.

My commission expires My Commission Expires Sept. 17, 1953

23-8390-s 6-51—20M

PLUGGING
FILE SEC 2 T 23 R 13 E
BOOK PAGE 63 LINE 9

15-185-00089

WELL LOG - KELLY #1

Location - C W/2 NW/4 SE/4 Section 2-23-13, Stafford County, Kansas

Owner - Sterling Drilling Company et al
Rotary Drilling Contractor - Sterling Drilling Company

Commenced -- 11-13-52
Completed - 12-1-52

Total Depth - 3896'

Elevation: Est. 1864 DF
1861 Gr

LOG

0- 313	Sand, Clay and Red Bed
313- 700	Red Bed
700- 730	Anhydrite
730-1540	Shale and Shells
1540-1700	Lime and Shale
1700-1875	Lime
1875-2025	Lime and Shale
2025-2150	Lime
2150-2875	Shale and Lime
2875-3045	Lime
3045-3145	Lime and Shale
3145-3242	Lime
3242-3245	Heebner
3245-3405	Lime and Shale
3405-3417	Shale
3417-3470	Kansas City Lime
3470-3670	Lime
3670-3735	Conglomerate
3735-3805	Lime and Shale
3805-3845	Shale
3845-3896	Lime

CASING RECORD

316' of 8-5/8" Surface Pipe
set at 313'
Cemented with 250 Sacks Bulk Cement
(3 sacks Chloride)

FORMATION TOPS:

Heebner	3260'
Brown Lime	3395'
Lansing-Kansas City	3417'
Marmaton	3630'
Conglomerate	3670'
Viola	3722'
Simpson	3778'
Arbuckle	3844'

PRODUCTION: Dry and Abandoned

TO WHOM IT MAY CONCERN: This is to certify that this a correct record of the drillers' time sheets for the Kelly #1 well.

(Signed) STERLING DRILLING COMPANY

By Rollin Mead
Rollin Mead - President

RECEIVED
STATE CORPORATION COMMISSION
DEC - 4 1952
CONSERVATION DIVISION
Wichita, Kansas

PLUGGING
FILE SEC. 2 T. 23 R. 13W
BOOK PAGE 63 LINE 9