


WELL PLUGGING RECORD

Give All Information Completely
Make Required Affidavit
Mail or Deliver Report to:
Conservation Division
State Corporation Commission
211 No. Broadway
Wichita, Kansas

Stafford County. Sec. 4 Twp. 23S Rge. (E) 13 (W)
Location as "NE/CNW/SW" or footage from lines SE SE SE
Lease Owner Stickle Drilling Company
Lease Name Green Well No. 1
Office Address 507 Bitting Building, Wichita 2, Kansas
Character of Well (completed as Oil, Gas or Dry Hole) Dry hole
Date well completed 14 March 19 56
Application for plugging filed 14 March 19 56
Application for plugging approved 14 March 19 56
Plugging commenced 14 March 19 56
Plugging completed 15 1/4 March 19 56
Reason for abandonment of well or producing formation Dry hole

NORTH

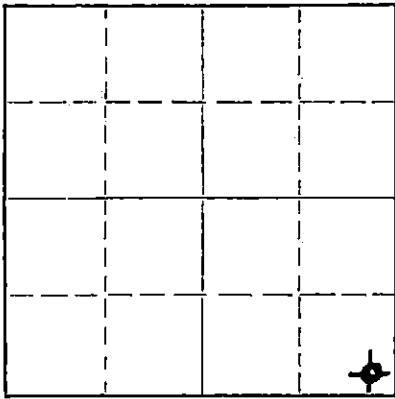

Locate well correctly on above Section Plat

If a producing well is abandoned, date of last production _____ 19____
Was permission obtained from the Conservation Division or its agents before plugging was commenced? Yes

Name of Conservation Agent who supervised plugging of this well R. M. Brundege, Hoisington, Kans.
Producing formation None Depth to top _____ Bottom _____ Total Depth of Well 3855 Feet
Show depth and thickness of all water, oil and gas formations.

OIL, GAS OR WATER RECORDS

CASING RECORD

FORMATION	CONTENT	FROM	TO	SIZE	PUT IN	PULLED OUT
Surface	water	0	250	8 5/8	299	None

Describe in detail the manner in which the well was plugged, indicating where the mud fluid was placed and the method or methods used in introducing it into the hole. If cement or other plugs were used, state the character of same and depth placed, from _____ feet to _____ feet for each plug set.

Heavy rotary mud from total depth to 270 feet through drill pipe

One-third sack hulls and Halliburton plug placed at 270 feet
35 sacks cement placed on plug through drill pipe by Halliburton

Heavy rotary mud to 40 feet

One-third sack hulls and Halliburton plug placed at 40 feet
10 sacks cement placed on plug through drill pipe by Halliburton

(If additional description is necessary, use BACK of this sheet)

Name of Plugging Contractor Stickle Drilling Company
Address 507 Bitting Building, Wichita 2, Kansas

STATE OF Kansas, COUNTY OF Sedgwick, ss.
R.B. Parriott (employee of owner) or (owner or operator) of the above-described well, being first duly sworn on oath, says: That I have knowledge of the facts, statements, and matters herein contained and the log of the above-described well as filed and that the same are true and correct. So help me God.

(Signature) R.B. Parriott

507 Bitting Building, Wichita 2, Kans.
(Address)

SUBSCRIBED AND SWORN TO before me this 16th day of March, 19 56.

My commission expires August 22, 1957

Gladys Grenary
Notary Public.

PLUGGING
FILE SEC 4 T 23 R 13W
BOOK PAGE 46 LINE 5

STATE OF KANSAS
MARCH 24 1956
CONSERVATION DIVISION
Wichita, Kansas
3-24-56

15-185-60910-0000

Stickle Drilling Company, et al
Tulsa, Oklahoma

Tulsa, Oklahoma
March 20, 1956

CONTRACTOR: Stickle Drilling Company
Drilling Commenced: March 4, 1956
Drilling Completed: March 15, 1956

Green #1 - SE/4 SE/4 SE/4
Section 4-23S-13W, Stafford
County, Kansas.

DRILLERS LOG

Depth Figures Indicates Base of Formation

Sand	150
Shale	289
Red Bed, Sand & Shale	870
Shale & Shells	910
Anhydrite	940
Shale & Shells	1595
Lime	1675
Lime & Shale	2075
Lime	2195
Lime & Shale	2250
Shale & Shells	2400
Shale & Lime	2550
Lime & Shale	2715
Shale & Shells	2905
Lime & Shale	3385
Douglas	3423
Brown Lime	3433
Kansas City Lime	3461
Lime	3523
Lime & Shale	3565
Lime	3628
Lime & Shale	3695
Marmaton Lime & Shale	3731
Conglomerate	3743
Lime	3785
Viola	3785
Viola Lime	3834
Shale & Lime	3855
Arbuckle	3855 TD

I, Frank E. Stickle, hereby certify the above to be a true and complete Drillers Log of Stickle Drilling Company, et al, Green #1, SE/4 SE/4 SE/4 of Section 4-23S-13W, Stafford County, Kansas.

Frank E. Stickle
Frank E. Stickle

Lillian T. Bonham
Notary Public

February 13, 1960

My Commission Expires

PLUGGING
FILE SEC 4 T 23 R 13W
BOOK PAGE 46 LINE 5