

15-185-00872-0000


WELL PLUGGING RECORD

Give All Information Completely  
Make Required Affidavit  
Mail or Deliver Report to:  
Conservation Division  
State Corporation Commission  
800 Biting Building  
Wichita, Kansas

Stafford County. Sec. 8 Twp. 23 Rge. 13 (X) (W)

Location as "NE/CNW/SW" or footage from lines NW NW SE  
Lease Owner Welch & Olsson Drilling Company, Inc.  
Lease Name Green Well No. 1  
Office Address 203 Rule Building, Wichita, Kansas  
Character of Well (completed as Oil, Gas or Dry Hole) D & A  
Date well completed September 3rd 1954  
Application for plugging filed October 19th 1954  
Application for plugging approved October 19th 1954  
Plugging commenced October 21st 1954  
Plugging completed October 29th 1954  
Reason for abandonment of well or producing formation Non-commercial

NORTH

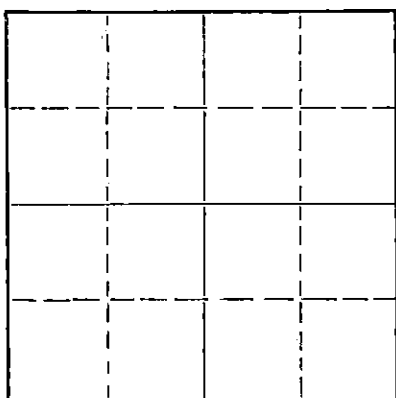

Locate well correctly on above  
Section Plat

If a producing well is abandoned, date of last production None 19  
Was permission obtained from the Conservation Division or its agents before plugging was commenced? Yes

Name of Conservation Agent who supervised plugging of this well M. A. Rives, Box 8, Bratt, Kansas  
Producing formation Arbuckle Depth to top 3860 Bottom 3865 Total Depth of Well 3865 Feet  
Show depth and thickness of all water, oil and gas formations.

OIL, GAS OR WATER RECORDS

CASING RECORD

FORMATION	CONTENT	FROM	TO	SIZE	PUT IN	PULLED OUT
				8 5/8"	290'	None
				5 1/2"	3918'	2890'

Describe in detail the manner in which the well was plugged, indicating where the mud fluid was placed and the method or methods used in introducing it into the hole. If cement or other plugs were used, state the character of same and depth placed, from \_\_\_\_\_ feet to \_\_\_\_\_ feet for each plug set.

First plug to 3670'. Dumped 500# of sand on plug and cemented with ten sacks.

Plugged hole with 20 sacks of Davis Gel and pumped second plug to 270'. Cemented with 106 sacks of cement with Service Truck.

11-17-54

(If additional description is necessary, use BACK of this sheet)

Name of Plugging Contractor R & D Casing Pulling Company  
Address Ellinwood, Kansas

STATE OF Kansas, COUNTY OF Sedgwick, ss.  
R. E. Welch (employee of owner) or (owner or operator) of the above-described well, being first duly sworn on oath, says: That I have knowledge of the facts, statements, and matters herein contained and the log of the above-described well as filed and that the same are true and correct. So help me God.

(Signature) *R. E. Welch*  
203 Rule Building, Wichita, Kansas  
(Address)

SUBSCRIBED AND SWORN to before me this 29th day of October, 1954

My commission expires June 12, 1955 Notary Public.

PLUGGING  
FILE SEC 4 T 23 R 13 W  
BOOK PAGE 71 LINE 36

