

15-185-00157-0001

STATE OF KANSAS
STATE CORPORATION COMMISSION


WELL PLUGGING RECORD

Give All Information Completely
Make Required Affidavit
Mail or Beliver Report to:
Conservation Division
State Corporation Commission
800 Bitting Building
Wichita, Kansas

OR
FORMATION PLUGGING RECORD

Strike out upper line
when reporting plug-
ging of formations.

Stafford County. Sec. 6 Twp. 23 Rge. 13 (E) (W)
Location as "NE $\frac{1}{4}$ NW $\frac{1}{4}$ SW $\frac{1}{4}$ " or footage from lines. NW NW NW
Lease Owner J. M. Huber Corporation
Lease Name Miller Well No. #1
Office Address Pratt, Kansas
Character of Well (completed as Oil, Gas or Dry Hole) Dry Hole
Date well completed Jan. 6, 1948 19
Application for plugging filed June 5, 1949 19
Application for plugging approved June 6, 1949 19
Plugging commenced June 7, 1949 19
Plugging completed June 7, 1949 19
Reason for abandonment of well or producing formation
Dry Hole
If a producing well is abandoned, date of last production 19
Was permission obtained from the Conservation Division or its agents before plugging was com-
menced? Yes

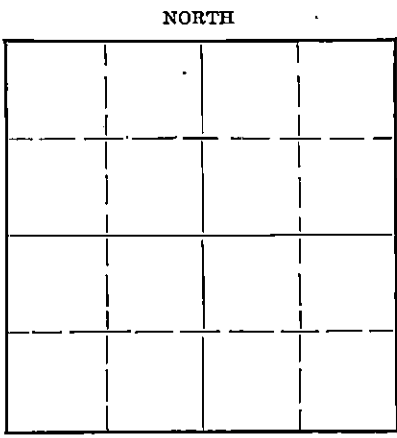

Locate well correctly on above
Section Plat

Name of Conservation Agent who supervised plugging of this well C. D. Stough - Great Bend
Producing formation Depth to top Bottom Total Depth of Well Feet
Show depth and thickness of all water, oil and gas formations.

OIL, GAS OR WATER RECORDS

CASING RECORD

Formation	Content	From	To	Size	Put In	Pulled Out
				10 3/4"	195'	195' None
				5 1/2"	3612'	3019'

Describe in detail the manner in which the well was plugged, indicating where the mud fluid was placed and the method or methods used in introducing it into the hole. If cement or other plugs were used, state the character of same and depth placed, from feet to feet for each plug set.

Forced plug to 3612' and pumped 20 sacks of cement through rotary drill pipe. Mudded hole to 195' and dumped 10 sacks. Mudded hole to within 30' of top and dumped 5 sacks.

8-6-49

RECEIVED
STUDY DIV
Conservation Div.
AUG 6 1949
CORPORATION
COMMISSION
KANSAS

(If additional description is necessary, use BACK of this sheet)

Correspondence regarding this well should be addressed to J. M. Huber Corporation
Address Drawer 460
Pratt, Kansas

STATE OF KANSAS, COUNTY OF PRATT, ss.
I, J. L. Kyler (employee of owner) or (owner/proprietor) of the above-described well,
being first duly sworn on oath, says: That I have knowledge of the facts, statements, and matters herein contained and the log of the above-described well as filed and that the same are true and correct. So help me God.

(Signature) _____

(Address) _____

Subscribed AND SWORN to before me this 5th day of August, 1949

My commission expires August 20, 1951

22-2625 2-48-15M



PLUGGING
FILE SEC 6 T 23 R 13W
BOOK PAGE 100 LINE 5

Notary Public.

J. M. HUBER CORPORATION

Drawer 460 . PRATT, KANSAS

15-185-00157-0001

COMPANY NAME: J. M. Huber Corporation
CONTRACTOR C-G Drilling Company
Farm Name No. 1 Miller

Location: NW NW NW
Section 6-23S-13W
Stafford Co., Kans.

COMMENCED: 12-23-47
COMPLETED: 1-6-48

ELEVATION: 1919'
PRODUCTION: D &A-

Shale - Red Bed	805
Anhydrite	830
Shale-Shells	1460
Salt-Shale-Shells	1645
Shale-Shells	1800
Lime	2180
Shale	2240
Lime-Shale	3200
Lime	3340
Lime-Shale	3405
Lime	3935
Total Depth	3935'

Sample Tops:

Anhydrite	805
Heebner	3226
Brn. Lansing	3465
Top Lansing	3487
Cherty Cong.	3782
Simpson	3831
Top Arbuckle	3885
T.D.	3935'

N.S. D & A

RECEIVED

COMMERCIAL

AUG 6 - 1949

STATE CORPORATION
COMMISSION
KANSAS

PLUGGING
FILE SEC. 6-23 R.D.W.
BOOK PAGE 100 LINE 5