

15-185-20375-0000


STATE OF KANSAS
STATE CORPORATION COMMISSION

Form CP-4

WELL PLUGGING RECORD

Give All Information Completely
Make Required Affidavit
Mail or Deliver Report to
Conservation Division
State Corporation Commission

P. O. Box 17027
Wichita, Kansas 67217
North

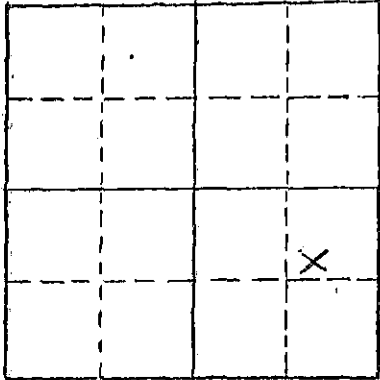

Locate well correctly on above
Section Plat

Stafford County. Sec. 6 Twp. 23 Rge. 13 (E)W (W)
Location as "NE/CNW4SW4" or footage from lines SW NE SE
Lease Owner: Wayne L. Kirkman Oil Operations
Lease Name: Corn Well No. #2
Office Address: P. O. Box 143 ; Great Bend, Ks. 67530
Character of Well (completed as Oil, Gas or Dry Hole)
Date well completed _____ 19____
Application for plugging filed April 19 74
Application for plugging approved April 19 74
Plugging commenced _____ 19____
Plugging completed May 3, 19 74
Reason for abandonment of well or producing formation _____

If a producing well is abandoned, date of last production _____ 19____
Was permission obtained from the Conservation Division or its agents before plugging was commenced? Yes

Name of Conservation Agent who supervised plugging of this well Russell Biberstein
Producing formation _____ Depth to top _____ Bottom _____ Total Depth of Well _____ Feet
Show depth and thickness of all water, oil and gas formations.

OIL, GAS OR WATER RECORDS

CASING RECORD

FORMATION	CONTENT	FROM	TO	SIZE	PUT IN	PULLED OUT
				8 5/8"	324	None
				5 1/2"	3933	2430

Describe in detail the manner in which the well was plugged, indicating where the mud fluid was placed and the method or methods used in introducing it into the hole. If cement or other plugs were used, state the character of same and depth placed, from _____ feet to _____ feet for each plug set.

Plugged off bottom, Allied Cementing Co. mixed and pumped down 5 1/2" casing; 1 sx of hulls, 10 sx of gel and 20 sx of cement to 3500'.
May 3, 1974 Plugged off top, Allied Cementing Co. mixed and pumped down 8 5/8" surface casing; 2 sx of hulls, 10 sx of gel and 100 sx of cement.

RECEIVED
STATE CORPORATION COMMISSION

JUL 17 1974

CONSERVATION DIVISION
Wichita, Kansas

(If additional description is necessary, use BACK of this sheet)


Name of Plugging Contractor: RUSS CASING PULLING, INC.
Address: P. O. Box 1082 ; Great Bend, Kansas 67530

STATE OF Kansas COUNTY OF Sedgwick ss.
E. F. Day (employee of owner) or (owner or operator) of the above-described

well, being first duly sworn on oath, says: That I have knowledge of the facts, statements, and matters herein contained and the log of the above described well as filed and that the same are true and correct. So help me God.

(Signature) E. F. Day
Box 18148, Wichita, Ks 67218
(Address)

Subscribed and sworn to before me this 16th day of July, 19 74

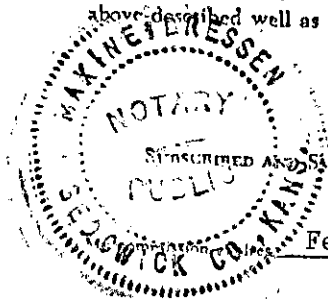

February 19, 1977

Maxine Dressen Notary Public.

B & B DRILLING, INC.

~~207 Petroleum Building~~ 720 UNION CENTER
Wichita, Kansas 67202

October 4, 1971

15-185-20375-0000

DRILLERS LOG

RECEIVED
STATE CORPORATION COMMISSION
APR 22 1974
CONSERVATION DIVISION
Wichita, Kansas

OPERATOR: Kirkman Oil Co.
CONTRACTOR: B & B Drilling, Inc.
COMMENCED: September 24, 1971
COMPLETED: October 1, 1971
TOTAL DEPTH: 3993'

Set 8 5/8" @ 324 w/225 sx

Re: Corn #2
SW NE SE Section 6-23S-13W
Stafford County, Kansas

0	343	Surface Hole	
343	790	Red Bed	
790	803	Anhydrite	
803	1934	Shale	
1934	2860	Shale	
2360	3040	Shale	
3040	3375	Lime & Shale	
3375	3505	Lime & Shale	
3505	3565	Lime	
3565	3857	Lime	
3857	3975	Lime	
3975	3985	Lime	
3985	3993	Lime	
3993		Total Depth	Ran 5 1/2" Set @ 3933' w/150 sx

We certify the above and foregoing to be true and correct copy of the log on the #2 Corn, located in Stafford County, Kansas.

Bill Lahan President

Alma A. Nease Notary Public

Subscribed and sworn to before me this 4th day of October, 1971. My commission expires May 31, 1974