


WELL PLUGGING RECORD

Give All Information Completely
Make Required Affidavit
Mail or File Report to:
Conservation Division
State Corporation Commission
800 Bittling Building
Wichita, Kansas

NORTH

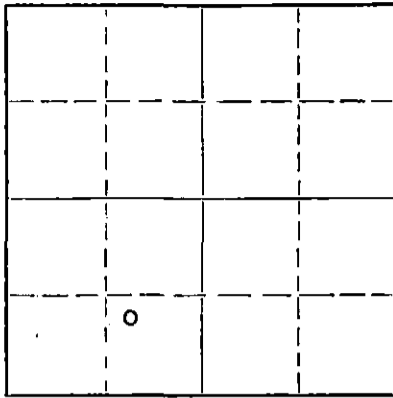

Locate well correctly on above Section Flat

Stafford County, Sec. 6 Twp. 23S Rge. 13 (X) (W)
Location as "NE/CNW%SW%" or footage from lines NW SE SW
Lease Owner Petroleum, Inc.
Lease Name Miller Well No. 1
Office Address 305 East Third, Wichita 2, Kansas
Character of Well (completed as Oil, Gas or Dry Hole) Dry Hole
Date well completed February 25, 1953
Application for plugging filed February 25, 1953
Application for plugging approved February 25, 1953
Plugging commenced February 25, 1953
Plugging completed February 25, 1953
Reason for abandonment of well or producing formation Dry Hole

If a producing well is abandoned, date of last production 19
Was permission obtained from the Conservation Division or its agents before plugging was commenced? Yes

Name of Conservation Agent who supervised plugging of this well Mr. M. A. Rives
Producing formation Depth to top Bottom Total Depth of Well 3946 Feet
Show depth and thickness of all water, oil and gas formations.

OIL, GAS OR WATER RECORDS

CASING RECORD

FORMATION	CONTENT	FROM	TO	SIZE	PUT IN	PULLED OUT
				8 1/2"	254'	None

Describe in detail the manner in which the well was plugged, indicating where the mud fluid was placed and the method or methods used in introducing it into the hole. If cement or other plugs were used, state the character of same and depth placed, from feet to feet for each plug set.

Mudded up to 240' and set wooden plug at 240'.
Cemented and displaced 20 sacks cement through
drill pipe onto plug at 240'. Mudded up to 35'
and set second wooden plug. Filled hole to
bottom of well cellar with 10 sacks cement.

3-4-53

(If additional description is necessary, use BACK of this sheet)


Name of Plugging Contractor Garvey Drilling Company
Address R. R. #2, Great Bend, Kansas

STATE OF KANSAS, COUNTY OF SEDGWICK, ss.
W. W. Fisher (employee of owner) of the above-described well, being first duly sworn on oath, says: That I have knowledge of the facts, statements, and matters herein contained and the log of the above-described well as filed and that the same are true and correct. So help me God.

(Signature) W. W. Fisher
305 East Third, Wichita, Kansas (Address)

SUBSCRIBED AND SWORN TO before me this 2nd day of March 19 53
Charlotte Sheisman Notary Public.

My commission expires October 13, 1954

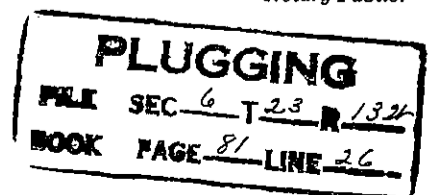

DRILLER'S LOG MILLER NO. 1

15-185-60157-0000

Petroleum, Inc., Operator
Garvey Drilling Company, Contractor

Section 6, Twp. 23S., Rge. 13W

Location: NW SE SW

Drilling Commenced: February 14, 1953
Drilling Completed: February 25, 1953

Stafford County, Kansas

R.T.D.: 3946'

Casing Record: 8 5/8" @ 254' w/175 sax

Production: D & A

Figures below indicate bottom of formation:

220	Sand & Gravel
245	Shale
254	Shale & Shells
485	Shale, Sand & Shells
813	Red Bed & Shale
840	Anhydrite
1460	Shale & Shells
1665	Lime & Shale
2175	Lime
3425	Lime & Shale
3811	Lime
3867	Viola
3913	Lime
3865	Shale
3946	Lime
3946'	R.T.D.

Tops:

Heebner:	3342 (-1414)
Brown Lime:	3471 (-1543)
Lansing:	3489 (-1561)
Simpson:	3865 (-1937)
Arbuckle:	3921 (-1993)

I hereby certify that this is a true and correct log of the above mentioned well.

PETROLEUM, INC.

By W. W. T. L.

STATE OF KANSAS)
) SS:
COUNTY OF SEDGWICK)

Subscribed to and sworn to before me, a Notary Public, in said County and State, this 2nd day of March, 1953.

Charlotee Heidman
Notary Public

My commission expires: October 13, 1954.

RECEIVED
STATE COMMISSION
MARCH 4 1953
CONCERNING DIVISION

PLUGGING
FILE SEC 6 T 23 R 132
BOOK PAGE 81 LINE 26