

15-185-60001-0000

STATE OF KANSAS  
STATE CORPORATION COMMISSION


Give All Information Completely  
Make Required Affidavit  
Mail or Deliver Report to:  
Conservation Division  
State Corporation Commission  
800 Bitting Building  
Wichita, Kansas

WELL PLUGGING RECORD

Stafford County. Sec. 10 Twp. 23S Rge. 13 (E) (W)

Location as "NE/CNW $\frac{1}{4}$ SW $\frac{1}{4}$ " or footage from lines NW NW SE  
Lease Owner Petroleum, Inc.  
Lease Name Hamilton Well No. 1  
Office Address 100 Derby Bldg., Wichita 2, Kansas  
Character of Well (completed as Oil, Gas or Dry Hole) Dry Hole  
Date well completed April 5, 1952  
Application for plugging filed April 5, 1952  
Application for plugging approved April 5, 1952  
Plugging commenced April 5, 1952  
Plugging completed April 5, 1952  
Reason for abandonment of well or producing formation Dry Hole

NORTH

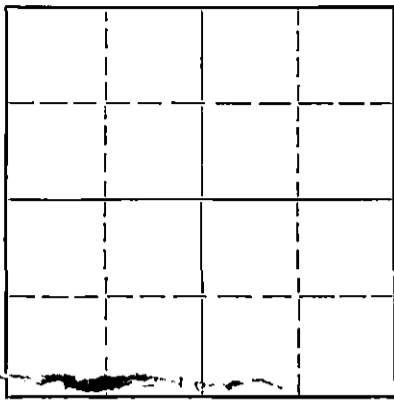

Locate well correctly on above Section Plat

If a producing well is abandoned, date of last production 19...  
Was permission obtained from the Conservation Division or its agents before plugging was commenced? Yes

Name of Conservation Agent who supervised plugging of this well Mr. Rives  
Producing formation Depth to top Bottom Total Depth of Well 396.1 Feet  
Show depth and thickness of all water, oil and gas formations.

OIL, GAS OR WATER RECORDS

CASING RECORD

Formation	Content	From	To	Size	Put In	Pulled Out
				8 5/8"	251'	None

Describe in detail the manner in which the well was plugged, indicating where the mud fluid was placed and the method or methods used in introducing it into the hole. If cement or other plugs were used, state the character of same and depth placed, from feet to feet for each plug set.

Mudded up to 250' and set wooden plug at 250'. Cemented and displaced 15 sack cement through drill pipe on top of plug. Mudded up to 35' and placed second wooden plug at 35'. Filled hole to bottom of cellar with 10 sack cement.

(If additional description is necessary, use BACK of this sheet)

Name of Plugging Contractor Garvey Drilling Company  
Address R. R. #2, Great Bend, Kansas

STATE OF KANSAS, COUNTY OF SEDGWICK, SS.  
W. W. Fisher (employee of owner) of the above-described well, being first duly sworn on oath, says: That I have knowledge of the facts, statements, and matters herein contained and the log of the above-described well as filed and that the same are true and correct. So help me God.

STATE CORPORATION COMMISSION  
APR 18 1952

(Signature) WW Fisher  
100 Derby Building, Wichita 2, Kansas  
(Address)

SUBSCRIBED AND SWORN to before me this 10th day of April, 1952  
Charlotte Hedden  
Notary Public.

My commission expires October 13, 1954

23-8390-s 6-51-20M

PLUGGING  
FILE SEC 10 T 23 R 130  
BOOK PAGE 7 LINE 3

15485-00001-0000

DRILLER'S LOG HAMILTON NO. 1

Petroleum, Inc., Lease Owner  
Garvey Drilling Company, Contractor  
Drilling Commenced: March 24, 1952  
Drilling Completed: April 5, 1952  
Casing Record: 251' of 8 5/8" w/175 sax

Section 10, Twp. 23S, Rge. 13W  
Location: NW NW SE  
County: Stafford  
Production: D & A  
R.T.D. 3961'

Figures below indicate bottom of formation:

45 Sand  
140 Clay  
251 Shale  
665 Red Bed & Shale  
755 Red Bed, Shale & Shells  
780 Anhydrite  
1440 Shale & Shells  
1700 Shale & Lime  
1800 Lime  
2475 Shale & Lime  
2595 Shells & Shale  
3215 Lime & Shale  
3320 Lime  
3365 Lime & Shale  
3425 Shale  
3470 Lime  
3512 Lime & Shale  
3688 Lime  
3753 Lime & Shale  
3766 Viola  
3805 Viola Lime  
3809 Shale Lime  
3861 Shale  
3961 Lime  
  
3961' R.T.D.

Tops:  
Heebner: 3280 (-1409)  
Brown Lime: 3415 (-1544)  
Lansing: 3432 (-1561)  
Arbuckle: 3861 (-1996)

**PLUGGING**  
FILE SEC 10 T 23 R 50  
BOOK PAGE 7 LINE 3

I hereby certify that this is a true and correct log of the above mentioned well.

PETROLEUM, INC.

**RECEIVED**  
STATE CORPORATION COMMISSION

By W W Fisher

STATE OF KANSAS )  
COUNTY OF SEDGWICK )

SS: APR 18 1952  
CONSERVATION DIVISION  
Wichita, Kansas

Subscribed to and sworn to before me, a Notary Public, in said County and State, this 10th day of April, 1952.

My commission expires: October 13, 1954

Charlotte Hester  
Notary Public