


STATE OF KANSAS
STATE CORPORATION COMMISSION
CONSERVATION DIVISION
P. O. BOX 17027
WICHITA, KANSAS 67217

WELL PLUGGING RECORD

Stafford County, Sec. 30 Twp. 22S Rge. 11W (W)

Location as "NE/CNW/SW" or footage from lines NE NE SW Approx.
Lease Owner John Jay Darrah, Jr. & Walter Innes Phillips, et al
Lease Name Nolte Well No. 1
Office Address 1010 Century Plaza Bldg., Wichita, Kansas
Character of Well (completed as Oil, Gas or Dry Hole) Dry Hole
Date well completed September 8, 1974
Application for plugging filed September 8, 1974
Application for plugging approved September 8, 1974
Plugging commenced September 8, 1974
Plugging completed September 8, 1974
Reason for abandonment of well or producing formation Dry Hole

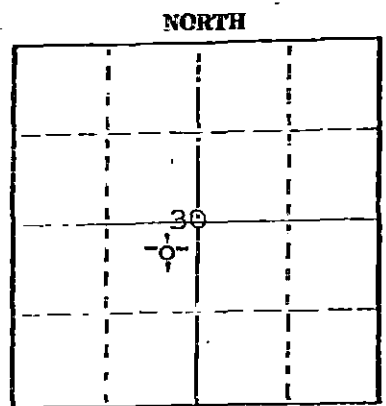

Locate well correctly on above Section Plat

If a producing well is abandoned, date of last production 19
Was permission obtained from the Conservation Division or its agents before plugging was commenced? Yes

Name of Conservation Agent who supervised plugging of this well
Producing formation Depth to top Bottom Total Depth of Well 3657 Feet
Show depth and thickness of all water, oil and gas formations.

OIL, GAS OR WATER RECORDS

CASING RECORD

FORMATION	CONTENT	FROM	TO	SIZE	FEET IN	PULLED OUT
		0'	231'	10-3/4"	231'	None

RECEIVED
STATE CORPORATION COMMISSION
SEP 18 1974
CONSERVATION DIVISION
Wichita, Kansas

Describe in detail the manner in which the well was plugged, indicating whether the method used was placed and the method or methods used in introducing it into the hole. If cement or other plugs were used, state the character of plugs and depth placed, from feet to feet for each plug set.

- 3657'-500' - Hole filled with mud & hulls.
- 500'-496' - Plug
- 496'-200' - 40 sacks cement
- 200'-196' - Plug
- 196'-40' - 30 sacks cement
- 40'-36' - Plug
- 36'-6' - 15 sacks cement
- 2 sacks cement in rat hole

(If additional description is necessary, use BACK of this sheet)

Name of Plugging Contractor: Halliburton Services
Address: Great Bend, Kansas

STATE OF KANSAS COUNTY OF SEDGWICK ss. John D. Knightley

(employee of owner) or (owner or operator) of the above-described well, being first duly sworn on oath, says: That I have knowledge of the facts, statements, and matters herein contained and the log of the above-described well as filed and that the same are true and correct. So help me God.

(Signature) [Signature]
301 S. Broadway, Wichita, Kansas 67202
(Address)

Subscribed and Sworn to before me this 16th day of September 1974

My commission expires March 12, 1975

[Signature]
Notary Public

John Jay Darrah, Jr. & Walter Innes Phillips, et al

Nolte #1
NE NE SW Sec. 30-22S-11W (Approx.)
Stafford County, Kansas

Contractor: D. R. Lauck Oil Company, Inc.
301 S. Broadway
Wichita, Kansas 67202

Commenced: August 30, 1974
Completed: September 8, 1974

RECEIVED
STATE CORPORATION COMMISSION
SEP 18 1974
CONSERVATION DIVISION
Wichita, Kansas

Drillers Log

Clay	40
Sand	115
Shale	231
Shale & Shells	561
Anhydrite	575
Shale & Shells	1020
Shale	1370
Shale & Lime Streaks	1500
Lime & Shale	2300
Shale & Lime	2755
Lime & Shale	2875
Lime	3657 RTD