


STATE OF KANSAS
STATE CORPORATION COMMISSION

Form CP-4

Give All Information Completely
Make Required Affidavit
Mail or Deliver Report to:
Conservation Division
State Corporation Commission
P. O. Box 17027
Wichita, Kansas 67217
NORTH

WELL PLUGGING RECORD

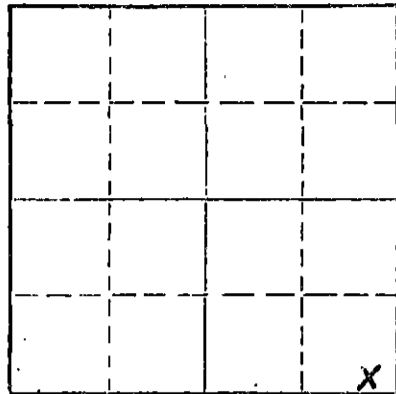

Locate well correctly on above
Section Plot

Stafford County, Sec. 30 Twp. 22 Rge. 11 (E) (W)
Location as "NE/CNW/SW" or footage from lines. SE SE SE
Lease Owner Clinton Oil Company
Lease Name Komarek #5 Well No.
Office Address Great Bend, Kansas 67530
Character of Well (completed as Oil, Gas or Dry Hole) Oil
Date well completed March 19 37
Application for plugging filed Feb 8 19 73
Application for plugging approved Feb 12 19 73
Plugging commenced 2/19/73 19
Plugging completed 2/26/73 19
Reason for abandonment of well or producing formation depleted.

If a producing well is abandoned, date of last production May 19 66
Was permission obtained from the Conservation Division or its agents before plugging was commenced? yes

Name of Conservation Agent who supervised plugging of this well Biberstein
Producing formation Arbuckle Depth to top 3548 Bottom 3580 Total Depth of Well 3580 Feet
Show depth and thickness of all water, oil and gas formations. (open hole)

OIL, GAS OR WATER RECORDS

CASING RECORD

FORMATION	CONTENT	FROM	TO	SIZE	PUT IN	PULLED OUT
Arbuckle	Oil	3548	3580	13"	220	none
				6"	3548	1595'

Describe in detail the manner in which the well was plugged, indicating where the mud fluid was placed and the method or methods used in introducing it into the hole. If cement or other plugs were used, state the character of same and depth placed, from feet to feet for each plug set.

Checked hole to 3580' and ran sand to 3525', ran 6 sacks cement.

Worked pipe to 12" tension, parted pipe in cellar. Welded on pipe, shot pipe at 2100', 1803', 1600', pulled 52 joints of 6" casing. Bailed hole to 200', set 10' rock bridge and ran 7 yards concrete.

PLUGGING COMPLETE.

RECEIVED
STATE CORPORATION COMMISSION
MAR 9 1973
CONSERVATION DIVISION
Wichita, Kansas

Name of Plugging Contractor KNIGHT CASING PULLING CO., INC.
Address CHASE, KANSAS

STATE OF KANSAS, COUNTY OF RICE, ss.
NOEL J. KNIGHT (employee of owner) or (owner or operator) of the above-described well, being first duly sworn on oath, says: That I have knowledge of the facts, statements, and matters herein contained and the log of the above-described well as filed and that the same are true and correct. So help me God.

(Signature) Noel Knight
CHASE, Kansas (Address)

SUBSCRIBED AND SWORN TO before me this 28th day of February, 1973

My commission expires
MARGARET MELCHER
NOTARY PUBLIC
Rice County, Kansas
My Commission Expires
Feb. 15, 1975

Margaret Melcher
Notary Public.

V. Komarek #5

FORMATION RECORD

SESESE 30-225-116

Give detailed description and thickness of all formations drilled through and contents of sand, whether dry, water, oil or gas. Stafford, Co. KS

Formation	Top	Bottom	Formation	Top	Bottom
Sand & Shells	0	115			
Shale & Shells	115	190			
Red Rock	190	540			
Anhydrite	540	560			
Red Rock & Blue Shale	560	605			
Shale & Shells	605	950			
Salt, Shale & Shells	950	1340			
Shale & Shells	1340	1425			
Broken Lime	1425	1510			
Shale & Shells	1510	1621			
Broken Lime	1621	1924			
Shale & Lime Shells	1924	1995			
Lime	1995	2024			
Broken Lime	2024	2392			
Shale & Lime Shells	2392	2452			
Broken Lime	2452	2904			
Lime	2904	3062			
Broken Lime	3062	3084			
Shale & Lime Shells	3084	3224			
Broken Lime	3224	3264			
Lime	3264	3294			
Broken Lime	3294	3499			
Shale	3499	3530			
Shale, Green (Cored)	3530	3543			
Dolomite-Top Siliceous	3543	3556			
Green Shale (Cored)	3556	3558			
Lime-Hard (Cored)	3558	3563			
Lime-Small Oil Show	3563	3572			
Lime-Free Oil	3572	3575			
Lime-Hard	3575	3577			
Lime-Sandy w/Free Oil	3577	3580			
	TD	3580			
Date of First Work		1-31-37			
Date Drilling Commenced		2-12-37			
Date Drilling Completed		3-27-37			
Date Put on Production		3-30-37			
Date Potential Effective		3-30-37			

3264
1924
-1444

RECEIVED
STATE CORPORATION COMMISSION
FEB 12 1973
CONSERVATION DIVISION
Wichita, Kansas

AUG 5 1937

ALFF BUCK