


STATE OF KANSAS  
STATE CORPORATION COMMISSION

Form CP-4

Give All Information Completely  
Make Required Affidavit  
Mail or Deliver Report to:  
Conservation Division  
State Corporation Commission  
P. O. Box 17027  
Wichita, Kansas 67217

WELL PLUGGING RECORD

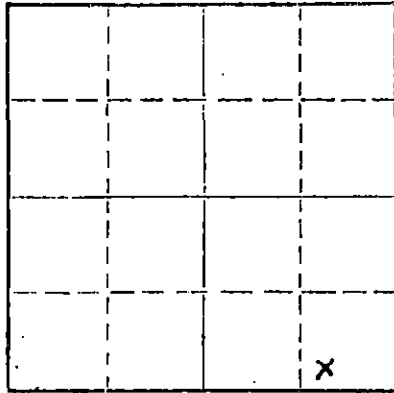

Locate well correctly on above  
Section Plat

Stafford County, Sec. 30 Twp. 22 Rge. 11W (E) (W)  
Location as "NE/CNW/SE/SW" or footage from lines 990' FEL 412' FSL SE/4  
Lease Owner Clinton Oil Company  
Lease Name V. Komarek #21 Well No.  
Office Address Great Bend, Kansas 67530  
Character of Well (completed as Oil, Gas or Dry Hole) oil  
Date well completed 8-9-71 19  
Application for plugging filed 6-6-73 19  
Application for plugging approved 6-6-73 19  
Plugging commenced 6/8/73 19  
Plugging completed 6/12/73 19  
Reason for abandonment of well or producing formation depleted.

If a producing well is abandoned, date of last production 10/71 19  
Was permission obtained from the Conservation Division or its agents before plugging was commenced? yes

Name of Conservation Agent who supervised plugging of this well Biberstein  
Producing formation L/KC Depth to top 3230 Bottom 3480 Total Depth of Well 3529 Feet  
Show depth and thickness of all water, oil and gas formations.

OIL, GAS OR WATER RECORDS

CASING RECORD

FORMATION	CONTENT	FROM	TO	SIZE	PUT IN	PULLED OUT
L/KC	oil	3360	3381	8-5/8 5 1/2"	350 3528	none 2400

Describe in detail the manner in which the well was plugged, indicating where the mud fluid was placed and the method or methods used in introducing it into the hole. If cement or other plugs were used, state the character of same and depth placed, from \_\_\_\_\_ feet to \_\_\_\_\_ feet for each plug set.

Checked hole to 3480', ran sand to 3300' and ran 5 sacks cement.  
Shot pipe at 2547', 2390', pulled 74 joints. Set 10' rock bridge  
at 320' and ran 5 yards ready mix.

PLUGGING COMPLETE.

RECEIVED  
STATE CORPORATION COMMISSION  
JUN 27 1973  
CONSERVATION DIVISION  
Wichita, Kansas


(If additional description is necessary, use BACK of this sheet)  
Name of Plugging Contractor KNIGHT CASING PULLING CO., INC.  
Address CHASE, KANSAS

STATE OF KANSAS COUNTY OF RICE ss.  
NOEL J. KNIGHT (employee of owner) or (owner or operator) of the above-described well, being first duly sworn on oath, says: That I have knowledge of the facts, statements, and matters herein contained and the log of the above-described well as filed and that the same are true and correct. So help me God.

(Signature) *Noel Knight*  
CHASE, KANSAS (Address)

SUBSCRIBED AND SWORN TO before me this 13th day of June, 1973

My commission expires

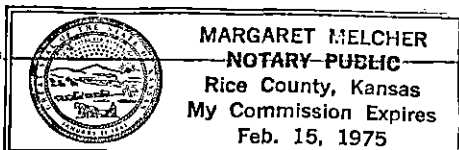

*Margaret Melcher*  
Notary Public.

# WELL LOG

COMPANY **Clinton Oil Company**  
 FARM **V. Komarek** NO. **21-D**  
 TOTAL DEPTH **3529'**  
 COMM. **7-20-71** COMP. **7-27-71**  
 CONTRACTOR **Garvey Drilling Company**

SEC. **30** T. **22S** R. **11W**  
 LOC. **App. SW SE SE**

COUNTY **Stafford, Kansas**


CASING

**8 5/8" @ 350' w/32Sex**  
**5 1/2" @ 3528' w/17Sex**

ELEVATION

PRODUCTION

FIGURES INDICATE BOTTOM OF FORMATIONS

- 30' Surface Soil
- 100' Sand & Gravel
- 533' Red Bed
- 559' Anhydrite
- 1265' Red Bed & Shale
- 1635' Shale & Lime
- 2240' Lime & Shale
- 2526' Shale
- 2770' Shale & Shells
- 2905' Shale & Lime
- 3294' Lime
- 3510' Lime & Shale
- 3529' Lime & Shale
- 3529' RTD

RECEIVED  
 STATE CORPORATION COMMISSION

JUN 6 1973

CONSERVATION DIVISION  
 Wichita, Kansas

State of Kansas }  
 County of Barton } SS

I, Charlene Marker of Garvey Drilling Company

upon oath state the above and foregoing is a true and correct copy of the log of the V. Komarek #21-D well.

Charlene Marker

Subscribed and sworn to before me this 2nd day of August 19 71

My Commission Expires: July 8, 1974

James A. [Signature]  
 NOTARY PUBLIC