

STATE OF KANSAS
STATE CORPORATION COMMISSION

WELL PLUGGING RECORD

Give All Information Completely
Make Required Affidavit
Mail or Deliver Report to:
Conservation Division
State Corporation Commission
800 Bittling Building
Wichita, Kansas

OR


FORMATION PLUGGING RECORD

Strike out upper line
when reporting plug-
ging of formations.

Stafford County, Sec. 12 Twp. 22 Rge. (E) 13 (W)

Location as "NE 1/4 NW 1/4 SW 1/4" or footage from lines SE SW NE
Lease Owner Davis Child Motor Company, Hutchinson, Ks.
Lease Name Dohrmann Well No. 1
Office Address Hutchinson, Ks.
Character of Well (completed as Oil, Gas or Dry Hole) dry hole
Date well completed August 30th 19 46
Application for plugging filed August 30th 19 46
Application for plugging approved August 30th 19 46
Plugging commenced August 30th 19 46
Plugging completed August 30th 19 46
Reason for abandonment of well or producing formation dry

NORTH

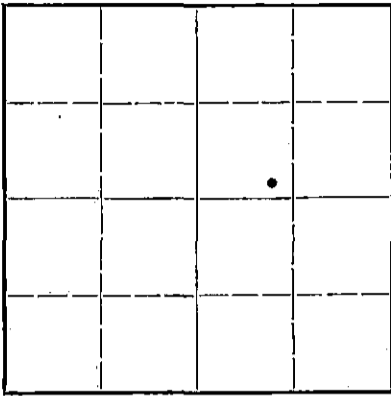

Locate well correctly on above
Section Plat

If a producing well is abandoned, date of last production 19
Was permission obtained from the Conservation Division or its agents before plugging was com-
menced? Yes

Name of Conservation Agent who supervised plugging of this well Herb Kerr, Great Bend, Ks.
Producing formation Depth to top Bottom Total Depth of Well 3721 Feet
Show depth and thickness of all water, oil and gas formations.

OIL, GAS OR WATER RECORDS


CASING RECORD

Formation	Content	From	To	Size	Put In	Pulled Out
				8 5/8"	299'	none

Describe in detail the manner in which the well was plugged, indicating where the mud fluid was placed and the method or methods used in introducing it into the hold. If cement or other plugs were used, state the character of same and depth placed, from feet to feet for each plug set.

Filled with heavy mud to 270', set bridge and cemented with fifteen sacks cement. Filled with heavy mud to within twenty feet of bottom of cellar, set bridge and cemented ten sacks cement.

12 22 (30)
71 8

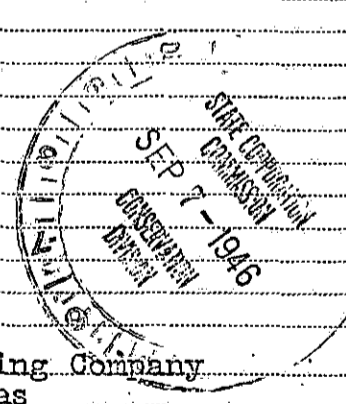

(If additional description is necessary, use BACK of this sheet)

Correspondence regarding this well should be addressed to Sterling Drilling Company
Address Sterling, Kansas

STATE OF Kansas, COUNTY OF Rice, ss.
Rollin Mead

being first duly sworn on oath, says: That I have knowledge of the facts, statements, and matters herein contained and the log of the above-described well as filed and that the same are true and correct. So help me God.

(Signature) Rollin Mead

Sterling, Kas.
(Address)

SUBSCRIBED AND SWORN to before me this 4th day of September, 1946

J. A. Mueller

Notary Public.

My commission expires Sept. 17th, 1949.

