

STATE OF KANSAS
STATE CORPORATION COMMISSION

Give All Information Completely
Make Required Affidavit
Mail or Deliver Report to:
Conservation Division
State Corporation Commission
800 Bitting Building
Wichita, Kansas


WELL PLUGGING RECORD

OR 15-009-05538-000

FORMATION PLUGGING RECORD

Strike out upper line when reporting plugging of formations.

NORTH

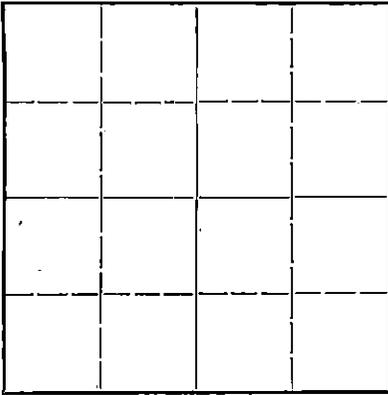

Locate well correctly on above Section Plat

BARTON County. Sec. 34 Twp. 16S Rge. (E) 11 (W)

Location as "NE $\frac{1}{4}$ NW $\frac{1}{4}$ SW $\frac{1}{4}$ " or footage from lines. Secn NW $\frac{1}{4}$

Lease Owner The Aylward Production Company

Lease Name Frees Well No. 1

Office Address 813 First Natl. Bank Bldg. Wichita, 2, Kansas.

Character of Well (completed as Oil, Gas or Dry Hole) Dry

Date well completed. October 15, 1946 19 46

Application for plugging filed. October 16, 1946. 19

Application for plugging approved. 19

Plugging commenced. October 25, 1946 19 46

Plugging completed. October 26, 1946 19 46

Reason for abandonment of well or producing formation. Dry

If a producing well is abandoned, date of last production. - 19

Was permission obtained from the Conservation Division or its agents before plugging was commenced? Yes

Name of Conservation Agent who supervised plugging of this well. Herbert Kerr

Producing formation. Depth to top. Bottom. Total Depth of Well 3420 Feet

Show depth and thickness of all water, oil and gas formations.


OIL, GAS OR WATER RECORDS

CASING RECORD

Formation	Content	From	To	Size	Put In	Pulled Out
				8" 5/8"	238'	none

Describe in detail the manner in which the well was plugged, indicating where the mud fluid was placed and the method or methods used in introducing it into the hole. If cement or other plugs were used, state the character of same and depth placed, from _____ feet to _____ feet for each plug set.

Mud bailed down to 230' from surface. Hole bridged and cemented with 15 sacks cement. Hole bridged at 30' and cemented with 5 sacks cement.

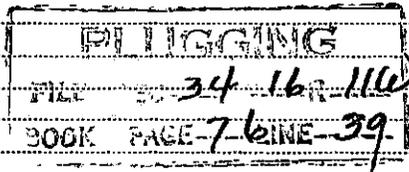

(If additional description is necessary, use BACK of this sheet)

Correspondence regarding this well should be addressed to The Aylward Production Company
Address 813 First Natl. Bank Bldg., Wichita, 2, Kansas.

STATE OF KANSAS, COUNTY OF ~~SHERIDAN~~ ELLIPSON, ss.

Lewis Stoy (employee of owner) or (owner or operator) of the above-described well, being first duly sworn on oath, says: That I have knowledge of the facts, statements, and matters herein contained and the log of the above-described well as filed and that the same are true and correct. So help me God.

(Signature) X Lewis Stoy

SUBSCRIBED AND SWORN to before me this 25th day of October

My commission expires Sept. 30th 1949



Casing Record:

Company: The Aylward Production Co.

Location:

8 5/8" - 228'

Contractor: Aylward Drilling Company

SE 1/4 of Sec.
34-16S-11W, Barton
County, Kansas

Commenced: October 6, 1946

Completed: October 15, 1946

Elevation: 1927'

Potential: Dry

<u>Formation</u>	<u>From</u>	<u>To</u>	<u>Remarks</u>
Clay & Sand	0	50	
Shale & Shells	50	228	8 5/8" Casing set at 228'
Shale	228	316	Cemented with 100 Sacks
Sand & Shale	316	420	
Shale	420	570	
Shale & Shells	570	590	
Shale & Red Rock	590	750	
Anhydrite & Shale	750	785	
Red Bed	785	830	
Shale & Shells	830	1090	
Shale	1090	1205	
Salt	1205	1330	
Shale & Shells	1330	1430	
Lime & Shale	1430	1495	
Lime	1495	1510	
Shale	1510	1665	
Lime & Shale	1665	1715	
Shale	1715	1750	
Lime & Shale	1750	1933	
Lime Shells	1933	1940	
Shale & Shells	1940	2095	
Shale	2095	2548	
Lime & Shale	2548	2755	
Lime	2755	3100	
Shale	3100	3120	
Lime	3120	3194	
Lime Soft	3194	3212	
Lime	3212	3420	T. D.

GEOLOGICAL DATA

Top Lensing	3079'	Total Depth 3420'
Top Conglomerate	3356'	
Top Rev. Arbuckle	3398'	All measurements corrected to Derrick Floor.
Top Arbuckle	3403'	

No shows - D&A

I hereby certify that this is a true and correct copy of the foregoing log, to the best of my knowledge.

Subscribed and sworn to before me this 22nd day of October, 1946

[Signature]

[Signature]

 Notary Public

My commission expires: February 25, 1950

34 16 11W
76 39

