


Give All Information Completely
Make Required Affidavit
Mail or Deliver Report to:
Conservation Division
State Corporation Commission
211 No. Broadway
Wichita, Kansas

WELL PLUGGING RECORD

1509-05537-0000

NORTH

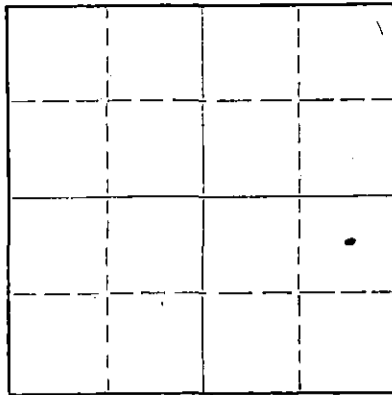

34 Locate well correctly on above Section Plat

BARTON County. Sec. 34 Twp. 16 Rge. 11 (EX W (W))
Location as "NE/CNW/SE/SW" or footage from lines NE-SE-NE
Lease Owner American Petrofina Company Of Texas
Lease Name Frees "A" # 11 Well No. 11 SWD
Office Address P. O. Box 209 Russell, Kansas 67665
Character of Well (completed as Oil, Gas or Dry Hole) S.W.D.
Date well completed September 13, 19 50
Application for plugging filed November 28, 19 67
Application for plugging approved November 29 19 67
Plugging commenced December 7, 19 67
Plugging completed December 7, 19 67
Reason for abandonment of well or producing formation Injection Capacity Uneconomical & Casing Bad.

If a producing well is abandoned, date of last production _____ 19 ____
Was permission obtained from the Conservation Division or its agents before plugging was commenced? Yes

Name of Conservation Agent who supervised plugging of this well Doanld Truan
Producing formation Arbuckle Depth to top 3415 Bottom 3624 Total Depth of Well 3624 Feet
Show depth and thickness of all water, oil and gas formations.

OIL, GAS OR WATER RECORDS

CASING RECORD

FORMATION	CONTENT	FROM	TO	SIZE	PUT IN	PULLED OUT
				8-5/8"	320'	0
				7"	1158'	0
Arbuckle	S.W.	3415	3624	5 1/2"	2410'	0

Describe in detail the manner in which the well was plugged, indicating where the mud fluid was placed and the method or methods used in introducing it into the hole. If cement or other plugs were used, state the character of same and depth placed, from 3624 feet to Surface feet for each plug set.

Pumped 10 Sax. Cement, 30 Sax Aquagel and 80 Sax. Cement.

DEC 19 1967
STATE CORPORATION COMMISSION
CONSERVATION DIVISION
WICHITA, KANSAS

(If additional description is necessary, use BACK of this sheet)

Name of Plugging Contractor Mixed & Pumped Cement & Mud. Allied Oilwell Cementing Company, Inc.
Address _____

STATE OF Kansas COUNTY OF Russell, ss.
American Petrofina Company Of Texas (employee of owner) or (owner or operator) of the above-described well, being first duly sworn on oath, says: That I have knowledge of the facts, statements, and matters herein contained and the log of the above-described well as filed and that the same are true and correct. So help me God.

(Signature) James B. Lane
P. O. Box 209, Russell, Kansas
(Address)

SUBSCRIBED AND SWORN TO before me this 15th. day of December, 19 67

My commission expires December 27, 1968

Verrel J. Brack
Notary Public.

STERLING DRILLING CO.

STERLING, KANSAS

RECEIVED
STATE CORPORATION COMMISSION

NOV 29 1967

CONSERVATION DIVISION
Wichita, Kansas

15-009-055370000

WELL LOG ----- PRIES "A" #11

Location - NE/4 SE/4 NE/4 of Section 34-16S-11W, Barton County, Kansas.

Owner - The El Dorado Refining Company
Contractor - Sterling Drilling Company

Commenced - 9-1-50
Completed - 9-13-50 (w/r)
Total Depth - 3626' (w/r)

C
O
P
Y

LOG

C- 40	Surface Soil and Clay
40- 755	Shale and Shells
755- 795	Anhydrite
795-1450	Shale and Shells
1450-1650	Shale and Lime
1650-2150	Lime
2150-2700	Shale and Lime
2700-2980	Lime
2980-3050	Shale and Lime
3050-3095	Shale
3095-3365	Lime
3365-3382	Lime and Shale
3382-3420	Conglomerate
3420-3475	Lime
3475-3523	Sandy Lime
3523-3626	Shale and Sand

CASING RECORD

320' of 8-5/8" Surface Pipe
Cemented with 150 Sacks Cement

3440' of 5 1/2" Casing
Cemented with 100 Sacks Cement

FORMATION TOPS, D.F.

Heebner	2986
Dodge	3004
Br. Ls	3089
Lans.	3101
Congl.	3380
Arb.	3415
Sdy. Dolo.	3510

12-15-54

cut of 5 1/2" casing at 1030' - Ran 7" casing to 1158' - cemented
w/ 250 sack cement