

WELL PLUGGING RECORD

OR

1509-05535-0000


FORMATION PLUGGING RECORD

Strike out upper line when reporting plugging of formations.

Give All Information Completely
Make Required Affidavit
Mail or Deliver Report to:
Conservation Division
State Corporation Commission
800 Bittling Building
Wichita, Kansas

Barton County. Sec. 34 Twp. 16 Rge. (E) 11 (W)
Location as "NE 1/4 NW 1/4 SW 1/4" or footage from lines NE SW NW
Lease Owner Hinkle Oil Company, et al.
Lease Name Frees Well No. 3
Office Address 914 Union National Bank Bldg., Wichita, Kansas.
Character of Well (completed as Oil, Gas or Dry Hole) Dry hole
Date well completed 5-15-51 19
Application for plugging filed 5-15-51 19
Application for plugging approved 5-15-51 19
Plugging commenced 5-15-51 19
Plugging completed 5-15-51 19
Reason for abandonment of well or producing formation.....

NORTH

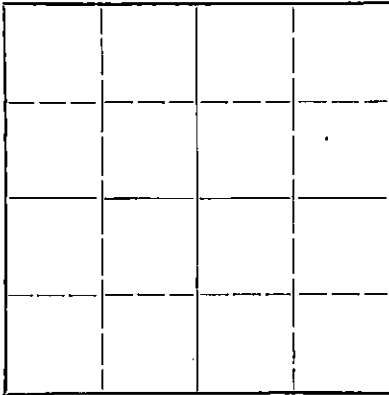

Locate well correctly on above Section Flat

If a producing well is abandoned, date of last production..... 19
Was permission obtained from the Conservation Division or its agents before plugging was commenced? yes

Name of Conservation Agent who supervised plugging of this well Harold J. Hollis
Producing formation..... Depth to top..... Bottom..... Total Depth of Well 3430 Feet
Show depth and thickness of all water, oil and gas formations.

OIL, GAS OR WATER RECORDS

CASING RECORD

Formation	Content	From	To	Size	Put In	Pulled Out
					97'	none

Describe in detail the manner in which the well was plugged, indicating where the mud fluid was placed and the method or methods used in introducing it into the hold. If cement or other plugs were used, state the character of same and depth placed, from..... feet to..... feet for each plug set.

15 sacks cement on bottom
mud to 100'
Set plug at 100'
mud to 40'
set plug at 40'
cemented with 10 sacks of cement.

RECEIVED
CORPORATION COMMISSION
MAY 22 1951
5-22-51
CONSERVATION DIVISION
Wichita, Kansas

(If additional description is necessary, use BACK of this sheet)

Correspondence regarding this well should be addressed to Hinkle Oil Company
Address 914 Union National Bank Bldg., Wichita, Kansas.

STATE OF Kansas COUNTY OF Sedgwick, ss.


J. B. Hinkle (owner) of the above-described well,
being first duly sworn on oath, says: That I have knowledge of the facts, statements, and matters herein contained and the log of the above-described well as filed and that the same are true and correct. So help me God.

(Signature) J. B. Hinkle
(Address)

SUBSCRIBED AND SWORN TO before me this 21st day of May, 1951.

My commission expires Jan. 17, 1954.

Murphy A. Lupton
Notary Public.

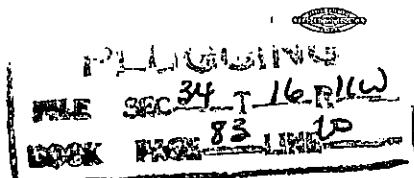

Casing Record
8 3/4 97'

Fracs No. 3. NE 1/4 SW 1/4 NW 1/4 34-16-11 Barton Co. Kansas.
Hinkle Oil Company, et al.
Contractor: J. D. Hinkle.
Commenced 5-3-51 Completed 5-14-51
Elevation 1940

0	70	clay and shells
70	100	sandy clay and shells
100	200	shale and shells
200	545	shale, shells and red bed
545	780	red bed sand
780	814	shale and shells
814	835	Andrydrite
835	1011	Shale and shells and red bed
1011	1380	shale, shells and salt
1380	1500	shale and shells
1500	2085	lime and shale
2085	2470	shale and shells
2470	2585	lime and shale
2585	2670	lime and shale sticky
2670	3125	lime and shale
3125	3295	lime
3295	3360	lime and shale
3360	3390	lime, shale and short
3390	3411	conglomerate, cherty
3411	3430	lime and shale

Tops:

Brown lime	3082
Lansing	3103
Conglomerate	3377
Artuckle	3411

State of Kansas)
County of Sedgwick) ss

I hereby certify that the above is a true and correct log as compiled from the daily drilling reports kept on said well.

And further affiant saith not.

J. B. Hinkle

Subscribed to and sworn to before me this 18th day of May, 1951.

Muriel A. Upton

My commission expires 1-17-54.

RECEIVED
STATE CORPORATION COMMISSION
MAY 23 1951
CONSERVATION DIVISION
Wichita, Kansas

PLUGGING
FILE SEC 34 T 16 R 11 W
BOOK PAGE 83 LINE 10