


Give All Information Completely
Make Required Affidavit
Mail or Deliver Report to:
Conservation Division
State Corporation Commission
212 No. Market
Wichita, Kansas

WELL PLUGGING RECORD

NORTH

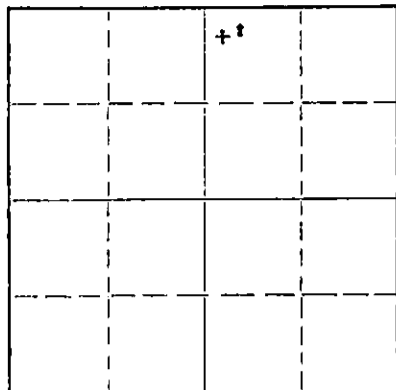

Locate well correctly on above
Section Plat

Barton County, Sec. 35 Twp. 16-SRge. 11 (E) 11 (W)
Location as "NE/CNW/SW" or footage from lines NW NW NE
Lease Owner SHELL Oil Co.
Lease Name Homolka, J. L. Well No. 1
Office Address 1700 Broadway, Denver, Colorado
Character of Well (completed as Oil, Gas or Dry Hole) Oil
Date well completed _____ 19____
Application for plugging filed 7/9/68 19____
Application for plugging approved 7/15/68 19____
Plugging commenced 9-3 12 Noon 1968
Plugging completed 9-3 2 P.M. 1968
Reason for abandonment of well or producing formation depleted oil well.

If a producing well is abandoned, date of last production 8/1 1968
Was permission obtained from the Conservation Division or its agents before plugging was commenced? yes

Name of Conservation Agent who supervised plugging of this well Donald Truen
Producing formation LKC Depth to top 3107 Bottom 3282 Total Depth of Well 3306PBTT Feet
Show depth and thickness of all water, oil and gas formations.

OIL, GAS OR WATER RECORDS

CASING RECORD

FORMATION	CONTENT	FROM	TO	SIZE	PUT IN	PULLED OUT
LKC	Oil			5 1/2"	3349	None
	---	3107	3282	8 5/8	383	None

Describe in detail the manner in which the well was plugged, indicating where the mud fluid was placed and the method or methods used in introducing it into the hole. If cement or other plugs were used, state the character of same and depth placed, from surface feet to 3306 feet for each plug set.

Mixed and pumped in 40 bbl. Howco Gel mud, mixed and displaced 250 cu. ft. Howco cement to fill 5 1/2" from surface to T. D. Mixed and displaced 50 sks cement between 5 1/2" and 8 5/8" casing. Plugging completed 2 p.m. 9/3/68

RECEIVED
STATE CORPORATION COMMISSION
SEP 11 1968
CONSERVATION DIVISION
Wichita, Kansas

(If additional description is necessary, use BACK of this sheet)

Name of Plugging Contractor Halliburton Cementing (Shell Oil Co. Plugger)
Address Same as Above

STATE OF Kansas, COUNTY OF Barton, ss.
E. L. Bearden (employee of owner) or (owner or operator) of the above-described

well, being first duly sworn on oath, says: That I have knowledge of the facts, statements, and matters herein contained and the log of the above-described well as filed and that the same are true and correct. So help me God.

(Signature) C. A. Winchhoff
P. O. Box 433 Russell, Kansas
(Address)

SUBSCRIBED AND SWORN TO before me this 9th day of September, 1968

My Commission expires Aug. 21, 1971

My commission expires _____

Janice P. Johnson
Notary Public.

15-009-19290-0000

LB

AK
LB
F

NW NW NE 35-166-11W
Barton County, Kansas

Contractor

(Trans Era Petroleum, Inc.)
Well - J. L. Bonolha #1

Total Depth: 3357'
Cora. 1/1/53
Comp. 1/10/53

Casing

Cement

8 5/8" Set @ 333'
5 1/2" Set @ 3349'

250 sacks Peoria
150 sacks Bulk

Formation	Depth
Shale-shells-sand streaks	100
Shale-shells	490
Red bed	733
Anhydrite	762
Shale-shells	1265
Salt-shale	1410
Shale-shells	1512
Lime-shale	1815
Ft. Riley	1895
Lime	2095
Lime-shale	2330
XShale	2660
Topeka Lime	2750
Lime	2940
Lime-shale	3025
Shale	3058
K.C. Lime	3155
Lime	3284
Lime-shale	3357'

RECEIVED
STATE CORPORATION COMMISSION
OCT 21 1968
CONSERVATION DIVISION
Wichita, Kansas

STATE OF KANSAS)
) ss
RUSSELL COUNTY)

I hereby certify that the above information is true and correct to the best of my knowledge.

Ann Ratz

Subscribed and sworn to before me this 13th day of January, 1953.

[Signature]
Notary Public

My commission expires: 2-8-54.

FILED
JAN 16 1953
NOTARY PUBLIC
WICHITA, KANSAS