


15-009-05552-0000

STATE OF KANSAS
STATE CORPORATION COMMISSION

Give All Information Completely
Make Required Affidavit
Mail or Deliver Report to:
Conservation Division
State Corporation Commission
800 Bitting Building
Wichita, Kansas

WELL PLUGGING RECORD

NORTH

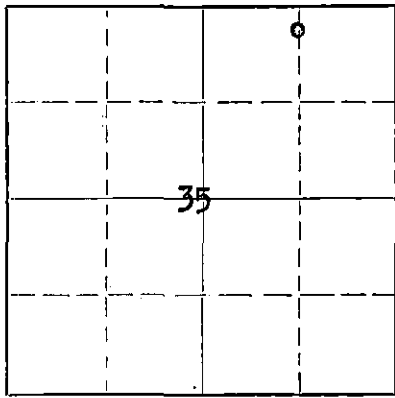

Locate well correctly on above
Section Plat

BARTON County, Sec. 35 Twp. 16S Rge. (E) 11 (W)

Location as "NE/CNW/SW" or footage from lines G N/2 N/2 NE

Lease Owner SHELL OIL COMPANY

Lease Name J. L. HOMOIKA Well No. 2

Office Address BOX 744, GREAT BEND, KANSAS

Character of Well (completed as Oil, Gas or Dry Hole) DRY HOLE

Date well completed FEBRUARY 17 1953

Application for plugging filed FEBRUARY 17 1953

Application for plugging approved FEBRUARY 18 1953

Plugging commenced FEBRUARY 17 1953

Plugging completed FEBRUARY 17 1953

Reason for abandonment of well or producing formation -

If a producing well is abandoned, date of last production - 19-

Was permission obtained from the Conservation Division or its agents before plugging was commenced? YES

Name of Conservation Agent who supervised plugging of this well C. D. STOUGH

Producing formation ARBUCKLE Depth to top 3367 Bottom - Total Depth of Well 3397 Feet

Show depth and thickness of all water, oil and gas formations.

OIL, GAS OR WATER RECORDS

CASING RECORD

FORMATION	CONTENT	FROM	TO	SIZE	PUT IN	PULLED OUT
ARBUCKLE	DRY	3367	3397	8 5/8"	387'	None

Describe in detail the manner in which the well was plugged, indicating where the mud fluid was placed and the method or methods used in introducing it into the hole. If cement or other plugs were used, state the character of same and depth placed, from _____ feet to _____ feet for each plug set.

FILLED HOLE TO 300' WITH ROTARY MUD.
PRECEDED HALLIBURTON PLUG WITH 1 SACK OF HULLS.
FOLLOWED HALLIBURTON PLUG WITH 1 SACK OF HULLS.
CAPPED PLUG WITH 25 SACKS OF CEMENT THROUGH DRILL PIPE.
FILLED HOLE WITH ROTARY MUD TO 31' FROM BOTTOM OF CELLAR.
RAN 10 SACKS OF CEMENT TO FINISH FILLING PIPE INTO BOTTOM OF CELLAR.

(If additional description is necessary, use BACK of this sheet)

Name of Plugging Contractor TRANS-ERA PETROLEUM, INC.

Address RUSSELL, KANSAS

STATE OF KANSAS, COUNTY OF BARTON, ss.

S. S. MARRY (employee of owner) of the above-described well, being first duly sworn on oath, says: That I have knowledge of the facts, statements, and matters herein contained and the log of the above-described well as filed and that the same are true and correct. So help me God.

(Signature) [Signature]

BOX 744, GREAT BEND, KANSAS
(Address)

SUBSCRIBED AND SWORN TO before me this 19th day of FEBRUARY, 19 53

[Signature]
Notary Public.

My commission expires APRIL 11, 1956

24-2675-S 2-52-20M

LB

PLUGGING
FILE SEC. 35 T 16 R 1134
BOOK PAGE 79 LINE 42

2-21-53

15-009-05552-0000

SHELL-J. L. HOMOLKA #2
C N₂ N₂ NE Section 35-16S-11W
Kraft-Prusa Field
Barton County, Kansas

CASING RECORD

8 5/8" cem 387' with 250 sax; cem circulated.

0 - 388 shale & shells
420 shale & shells
495 shale
720 red bed & shale
745 anhydrite
795 shale & shells
920 red bed
1220 shale & shells
1365 salt & shale
1710 shale & lime
1725 lime
2135 lime & shale
2210 lime
2790 lime & shale
2855 lime
2870 lime & shale
2994 lime
3075 shale
3200 lime
3210 lime
3275 shale & lime
3367 lime
3397 dolomite T.D.

Formation Tops

Topeka 2702
Toronto 2969
Brown Lime 3053
Lansing-Kansas City 3066
Sooy 3350
Arbuckle 3367

LB

PLUGGING
FILE SEC 36 T 16 R 1124
BOOK PAGE 79 LINE 42

RECEIVED