

WELL PLUGGING RECORD

OR


15009-05549-0000

Give All Information Completely  
Make Required Affidavit  
Mail or Deliver Report to:  
Conservation Division  
State Corporation Commission  
800 Bitting Building  
Wichita, Kansas

FORMATION PLUGGING RECORD

Strike out upper line  
when reporting plugging  
off formations.

NORTH

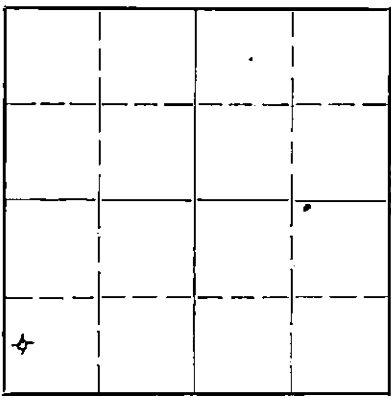

Locate well correctly on above  
Section Plat

Barton County, Sec 35 Twp 16 Rge. (E) 11 (W)  
Location as "NE $\frac{1}{4}$ NW $\frac{1}{4}$ SW $\frac{1}{4}$ " or footage from lines C W/2 SW/4 SW/4  
Lease Owner The Derby Oil Company  
Lease Name Freese "B"  
Office Address Wichita, Kansas  
Character of Well (completed as Oil, Gas or Dry Hole) Dry Hole  
Date well completed June 19, 1944  
Application for plugging filed June 20, 1944  
Application for plugging approved June 22, 1944  
Plugging commenced June 19, 1944  
Plugging completed June 19, 1944  
Reason for abandonment of well or producing formation Not Productive

If a producing well is abandoned, date of last production 19  
Was permission obtained from the Conservation Division or its agents before plugging was commenced? Yes - "Agent"

Name of Conservation Agent who supervised plugging of this well Eldon Petty  
Producing formation None Depth to top Bottom Total Depth of Well 3405 Feet  
Show depth and thickness of all water, oil and gas formations.

OIL, GAS OR WATER RECORDS

CASING RECORD


Formation	Content	From	To	Size	Put In	Pulled Out
				8 5/8"	568'	None

Describe in detail the manner in which the well was plugged, indicating where the mud fluid was placed and the method or methods used in introducing it into the hold. If cement or other plugs were used, state the character of same and depth placed, from feet to feet for each plug set.

3405' to 530' Heavy mud  
530' to 480' 15 sacks of cement  
480' to 30' Heavy mud  
30' to 5' 10 sacks of cement  
5' to surface Earth

7-24-44

DI PLUGGING  
FILE 35 16 - 44  
BOOK 121 - 2

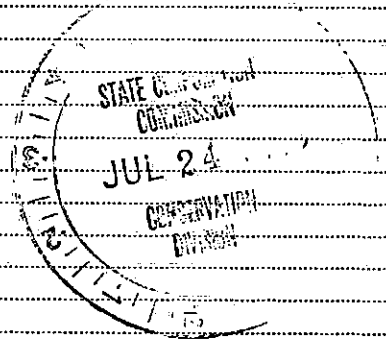

(If additional description is necessary, use BACK of this sheet)

Correspondence regarding this well should be addressed to The Derby Oil Company  
Address Wichita, Kansas

STATE OF Kansas, COUNTY OF Sedgwick, ss.  
S. E. Banks (employee of owner) or (owner or operator) of the above-described well,

being first duly sworn on oath, says: That I have knowledge of the facts, statements, and matters herein contained and the log of the above-described well as filed and that the same are true and correct. So help me God.

(Signature) S. E. Banks

Wichita, Kansas (Address)

SUBSCRIBED AND SWORN to before me this 20th day of July 1944

My commission expires July 31, 1947

(Signature)  
Notary Public.