


WELL PLUGGING RECORD

Give All Information Completely
Make Required Affidavit
Mail or Deliver Report to:
Conservation Division
State Corporation Commission
800 Bitting Building
Wichita, Kansas

Barton County. Sec. 35 Twp. 16S Rge. 11 (E) (W)

Location as "NE/CNW $\frac{1}{4}$ SW $\frac{1}{4}$ " or footage from lines SE $\frac{1}{4}$ NE $\frac{1}{4}$ NW $\frac{1}{4}$
Lease Owner The El Dorado Refining Company
Lease Name Anna Ehler "B" Well No. 2
Office Address 407 Brown Bldg., Wichita, Kansas
Character of Well (completed as Oil, Gas or Dry Hole) Dry Hole
Date well completed 7-31- 19 52
Application for plugging filed 7-31 19 52
Application for plugging approved 7-31 19 52
Plugging commenced 8-1 19 52
Plugging completed 8-1 19 52
Reason for abandonment of well or producing formation Dry Hole

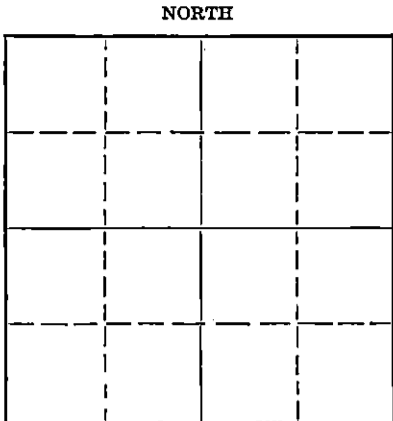

Locate well correctly on above Section Flat

If a producing well is abandoned, date of last production 19
Was permission obtained from the Conservation Division or its agents before plugging was commenced? Yes.

Name of Conservation Agent who supervised plugging of this well C. D. Stough
Producing formation Depth to top Bottom Total Depth of Well Feet
Show depth and thickness of all water, oil and gas formations.

OIL, GAS OR WATER RECORDS

CASING RECORD

Formation	Content	From	To	Size	Put In	Pulled Out
				8-5/8"	311'	

Describe in detail the manner in which the well was plugged, indicating where the mud fluid was placed and the method or methods used in introducing it into the hole. If cement or other plugs were used, state the character of same and depth placed, from _____ feet to _____ feet for each plug set.

Laid down 1/2 of drill pipe.
Filled hole with heavy mud to 1700'.
Finished laying down drill pipe.
Set bottom plug at 300'.
Cemented through drill pipe with 20 sacks cement.
Filled hole with heavy mud to 30'. Set top plug.
Cemented with 10 sacks cement.

RECEIVED
STATE CORPORATION COMMISSION
AUG 12 1952
CONSERVATION DIVISION
Wichita, Kansas

8-12-52

(If additional description is necessary, use BACK of this sheet)
Name of Plugging Contractor Sterling Drilling Company
Address 304 N. Broadway
Sterling, Kansas

STATE OF Kansas, COUNTY OF Rice, ss.
Rollin Mead (employee of owner) Notary Public of the above-described well,
being first duly sworn on oath, says: That I have knowledge of the facts, statements, and matters herein contained and the log of the above-described well as filed and that the same are true and correct. So help me God.

(Signature) Rollin Mead
Sterling, Kansas
(Address)

SUBSCRIBED AND SWORN to before me this 6th day of August, 19 52

My commission expires 9-17-53 Notary Public.

PLUGGING
FILE SEC 35 Twp 16S Rge 11
BOOK PAGE 35 LINE 1

15-009-05543-0000

STERLING DRILLING CO.

STERLING, KANSAS

WELL LOG ----- #2 ANNA EHLER "B"

Location - SE/4 NE/4 NW/4 Section 35-16S-11W, Barton County, Kansas

Owner - The El Dorado Refining Company
Drilling Contractor - Sterling Drilling Company

Commenced - 7-22-52
Completed - 7-31-52

Total Depth - 3428'

LOG

0- 180	Shale and Shells
180- 240	Sand and Shale
240- 312	Shale and Shells
312- 400	Red Bed and Shale
400- 750	Sand and Red Bed
750-1315	Shale and Red Bed
1315-1480	Shale
1480-1835	Shale and Lime
1835-1900	Lime
1900-2170	Shale and Lime
2170-2360	Shale and Shells
2360-2685	Shale and Lime
2685-2975	Lime
2975-3045	Shale
3045-3380	Lime
3380-3400	Conglomerate
3400-3428	Lime

CASING RECORD

318' of 8-5/8" Surface Pipe
Cemented at 311' with 250 Sacks Bulk
Cement

PRODUCTION: Dry and Abandoned

RECEIVED
STATE CONSERVATION COMMISSION

AUG 12 1952

CONSERVATION DIVISION
Wichita, Kansas

PLUGGING
 FILE SEC. 35 T. 16 N. 11 W.
 BOOK PAGE 35 LINE 1