

STATE OF KANSAS
STATE CORPORATION COMMISSION


WELL PLUGGING RECORD

Give All Information Completely
Make Required Affidavit
Mail or Deliver Report to:
Conservation Division
State Corporation Commission
212 No. Market
Wichita, Kansas

Stafford County, Sec 1 Twp 22 Rge 14 (E) (W)

Location as "NE/CNW/SW" or footage from lines NW NW SW
Lease Owner Cheyenne Exploration
Lease Name Hall #1 Well No. _____
Office Address Augusta, Kansas
Character of Well (completed as Oil, Gas or Dry Hole) _____
Date well completed _____ 19____
Application for plugging filed _____ 19____
Application for plugging approved _____ 19____
Plugging commenced 8/23/68 19____
Plugging completed 8/27/68 19____
Reason for abandonment of well or producing formation depleted.

NORTH

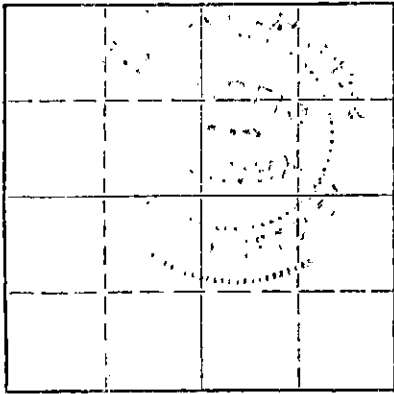

Locate well correctly on above
Section Plat

If a producing well is abandoned, date of last production _____ 19____
Was permission obtained from the Conservation Division or its agents before plugging was commenced? yes

Name of Conservation Agent who supervised plugging of this well Warren
Producing formation _____ Depth to top _____ Bottom _____ Total Depth of Well 3860 Feet
Show depth and thickness of all water, oil and gas formations.

OIL, GAS OR WATER RECORDS


CASING RECORD

FORMATION	CONTENT	FROM	TO	SIZE	PUT IN	PULLED OUT
				8-5/8	330'	none
				4 1/2"	3860'	3011'

Describe in detail the manner in which the well was plugged, indicating where the mud fluid was placed and the method or methods used in introducing it into the hole. If cement or other plugs were used, state the character of same and depth placed, from _____ feet to _____ feet for each plug set.


Checked hole to 3860', pushed plug to 3450' and ran 10' of sand.
Dumped 5 sacks of cement, shot pipe at 3197', 3100', 3030',
worked pipe loose and pulled 92 joints. Pumped 5 sacks of mud,
30 sacks of cement, displaced cement to 300', removed 8-5/8 swedge.
Filled hole to 40', set 10' rock bridge to 30' and dumped 10 sacks
of cement.

PLUGGING COMPLETE.

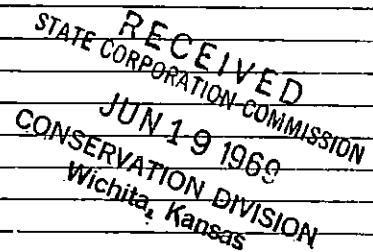

(If additional description is necessary, use BACK of this sheet)
Name of Plugging Contractor KNIGHT CASING PULLING CO., INC.
Address CHASE, KANSAS

STATE OF KANSAS, COUNTY OF RICE, ss.
NOEL J. KNIGHT (employee of owner) or (owner or operator) of the above-described well, being first duly sworn on oath, says: That I have knowledge of the facts, statements, and matters herein contained and the log of the above-described well and that the same are true and correct. So help me God.

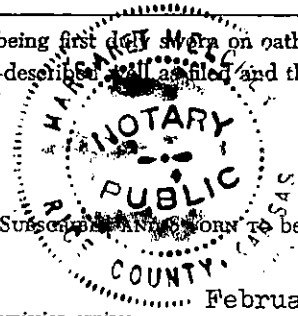

(Signature) Paul Knight
CHASE, KANSAS

(Address)

Subscribed and sworn to before me this 28th day of August, 19 68

Margaret Melcher
Notary Public.

My commission expires February 15, 1971