

STATE OF KANSAS
STATE CORPORATION COMMISSION

WELL PLUGGING RECORD


OR

FORMATION PLUGGING RECORD

Strike out upper line
when reporting plugging
of formations.

Give All Information Completely
Make Required Affidavit
Mail or Deliver Report to:
Conservation Division
State Corporation Commission
800 Bittling Building
Wichita, Kansas

NORTH

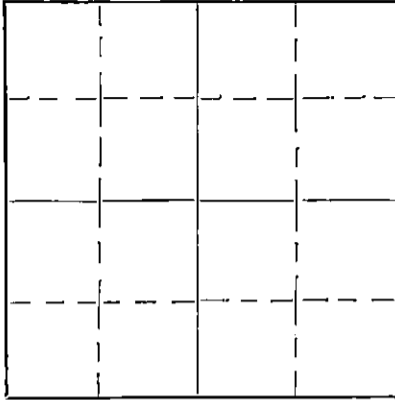

Locate well correctly on above
Section Plat

Stafford County. Sec. 1 Twp. 22 S Rge. 14 W (E) (W)
Location as "NE $\frac{1}{4}$ NW $\frac{1}{4}$ SW $\frac{1}{4}$ " or footage from lines 330' fr SL, 660' fr EL, NE/4
Lease Owner Phillips Petroleum Company
Lease Name Bordewick Well No. One
Office Address Box 779, Great Bend, Kansas
Character of Well (completed as Oil, Gas or Dry Hole) Dry hole
Date, well completed December 9, 1942
Application for plugging filed December 9, 1942
Application for plugging approved December 9, 1942
Plugging Commenced December 9, 1942
Plugging Completed December 9, 1942
Reason for abandonment of well or producing formation Dry hole

If a producing well is abandoned, date of last production _____ 193_____
Was permission obtained from the Conservation Division or its agents before plugging was commenced? Yes

Name of Conservation Agent who supervised plugging of this well Mr. C.T. Alexander
Producing formation Arbuckle Depth to top 3804' Bottom 3831' Total Depth of Well 3831' Feet
Show depth and thickness of all water, oil and gas formations.


OIL, GAS OR WATER RECORDS

CASING RECORD

Formation	Content	From	To	Size	Put In	Pulled Out
L.K.C.	No shows	3390		8-5/8"	427'	None.
Conglomerate	No shows	3655				
Viola	SS oil	3741				
Simpson	No shows	3756				
Arbuckle	No shows	3804	3831 TD			

Describe in detail the manner in which the well was plugged, indicating where the mud fluid was placed and the method or methods used in introducing it into the hole. If cement or other plugs were used, state the character of same and depth placed, from _____ feet to _____ feet for each plug set.

Filled hole w/ mud laden fluid from 3831', TD, to 427'. Bridged hole at 427' and spotted 15 sack cement from 427 to 372'. Mud laden fluid from 372' to 26'. 10 sack cement from 26' to cellar.

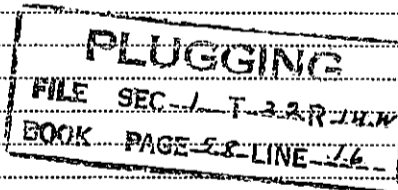

12-15-42

(If additional description is necessary, use BACK of this sheet)

Correspondence regarding this well should be addressed to Mr. F.W. Shelton
Address Box 779, Great Bend, Kansas

STATE OF KANSAS, COUNTY OF BARTON, ss.
F.W. Shelton (employee of owner) or (owner or operator) of the above-described well,

being first duly sworn on oath, says: That I have knowledge of the facts, statements, and matters herein contained and the log of the above-described well as filed and that the same are true and correct. So help me God.

(Signature) F.W. Shelton

Box 779, Great Bend, Kansas
(Address)

SUBSCRIBED AND SWORN to before me this 10th. day of December, 1942

My commission expires March 27, 1946 J.A. Smarsh Notary Public.

Form No. 879

Formation Record

Lease

BORDENICK

Well No. ^{CNE}

350' fr South, 860' fr East lines of NE/4 of Sec. 1-223-14W, Stafford Co., Kas.

FROM	TO	Formation	REMARKS
			ELEVATION 1921', D.F.
			SPUDDED 7:30 AM, 11-21-42.
0	250	Shells, shale & sand	
250	292	Sand and gravel	
292	450	Shale, Shells and Red Bed	8-5/8" csg. & 427' w/ 350 Sax cement.
450	1019	Shale, Red bed, Anhydrite	TOP ANHYDRITE 750'
1019	1600	Shale and shells	
1600	1685	Gyp	
1685	1686	Shale and lime shells	
1686	1777	Gyp and Lime	
1777	1870	Lime w/ shale breaks	
1870	2120	Lime and shale	
2120	2214	Lime w/ shale breaks	
2214	3047	Shale and lime	
3047	3093	Lime	
3093	3220	Lime	
3220	3357	Shale and lime	
3357	3451	Lime	TOP R.C. 3390'.
3451	3622	Lime	
3622	3656	Lime and shale	TOP CONGLOMERATE 3655'.
3656	3700	Lime and shale	TOP VIOLA 3684'.
3700	3705	Lime	
3705	3719	Lime - (Cored)	REC. VSS HEAVY BLACK OIL.
3719	3728	Lime	
3728	3741	Lime and chert	
3741	3750	Chert	
3750	3763	Shale	TOP SIMPSON 3755'.
3763	3793	Chert	
3793	3801	Green shale and chert	
3801	3804	Cherty lime.	
3804	3831	Arbuckle	TOP ARBUCKLE 3804'.
			NO SPOGS - D & A
			PLUGGED 12-9-42.
			Mr. C.T. Alexander, Plugging Inspector.

PLUGGING
 FILE SEC-1-F-22R14W
 BOOK PAGE-52 LINE-16