


WELL PLUGGING RECORD

Give All Information Completely
Make Required Affidavit
Mail or Delivery Report to:
Conservation Division
State Corporation Commission
211 No. Broadway
Wichita, Kansas

NORTH

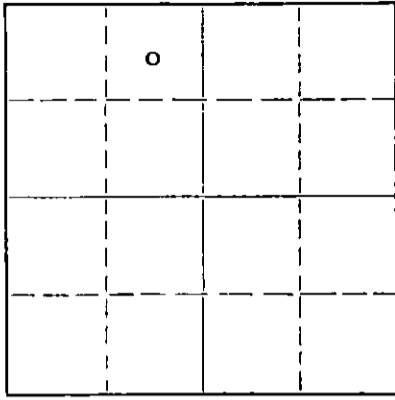

Locate well correctly on above Section Plat

Stafford County. Sec. 16 Twp. 22 Rge. 13 ~~xxx~~ (W)
Location as "NE/CNW/SW" or footage from lines NE NE NW
Lease Owner Hilton Drilling Company, Inc.
Lease Name Cassady Well No. 1
Office Address Great Bend, Kansas
Character of Well (completed as Oil, Gas or Dry Hole) dry hole
Date well completed August 13, 19 57
Application for plugging filed August 18, 19 57
Application for plugging approved August 19, 19 57
Plugging commenced August 18, 19 57
Plugging completed August 18, 19 57
Reason for abandonment of well or producing formation dry

If a producing well is abandoned, date of last production _____ 19____
Was permission obtained from the Conservation Division or its agents before plugging was commenced? R. M. Brundege

Name of Conservation Agent who supervised plugging of this well _____
Producing formation _____ Depth to top _____ Bottom _____ Total Depth of Well 3825' Feet
Show depth and thickness of all water, oil and gas formations.

OIL, GAS OR WATER RECORDS

CASING RECORD

FORMATION	CONTENT	FROM	TO	SIZE	PUT IN	PULLED OUT
				8-5/8"	300	None

Describe in detail the manner in which the well was plugged, indicating where the mud fluid was placed and the method or methods used in introducing it into the hole. If cement or other plugs were used, state the character of same and depth placed, from _____ feet to _____ feet for each plug set.

Hole filled to 210' with drilling mud, plug set at 210'
with 20 sacks cement and 1/3 sacks hulls.
Filled hole with mud to 20', plug set at 20' with 5
sacks cement and 1/3 sack hulls.

(If additional description is necessary, use BACK of this sheet)

Name of Plugging Contractor Hilton Drilling Company, Inc.
Address Great Bend, Kansas

STATE OF KANSAS, COUNTY OF BARTON, ss.
Jack L. Craft, Assistant Secretary (employee of owner) or (owner or operator) of the above-described well, being first duly sworn on oath, says: That I have knowledge of the facts, statements, and matters herein contained and the log of the above-described well as filed and that the same are true and correct. So help me God.

(Signature) Jack L. Craft
Great Bend, Kansas
(Address)

SUBSCRIBED AND SWORN to before me this 18th day of August, 19 57

Mildred Hobbie
Notary Public.

My commission expires _____

PLUGGING
FILE SEC. 16 T. 22 R. 13W
BOOK PAGE 37 LINE 19

MILDRED HOBBIE
COMMISSION EXPIRES MARCH 6, 1958
8-23-57

DRILLER'S LOG

COMPANY: HILTON DRILLING COMPANY, INC.

LOCATION: NE NE NW

CONTRACTOR: HILTON DRILLING COMPANY, INC.

SECTION 16-22S-13W

STAFFORD COUNTY, KANSAS

FARM NAME: CASSADY No. 1

ELEVATION: 1898' D. F.

1901' K. B.

COMMENCED: AUGUST 1, 1957

CASING Used: 8-5/8" SET @ 300' w/250 sxs.

COMPLETED: AUGUST 13, 1957

SAND, CLAY AND GRAVEL	265
SHALE AND RED BED	300
RED BED	370
SAND	390
SAND, RED BED AND SHALE	755
ANHYDRITE	785
SHALE AND SHELLS	1420
LIME AND SHALE	1745
LIME	1990
LIME AND SHALE	2145
LIME	3067
LIME AND CHERT	3725
LIME	3799
TOTAL DEPTH	3825

STATE OF KANSAS)
COUNTY OF BARTON) SS.

I, THE UNDERSIGNED, BEING DULY SWORN ON OATH, STATE THAT THE ABOVE STATEMENT AND LOG ARE TRUE AND A CORRECT RECORD AND LOG OF THE WELL DRILLED AT THE LOCATION ABOVE-DESCRIBED.

HILTON DRILLING COMPANY, INC.

Jack L. Gault

SUBSCRIBED AND SWORN TO BEFORE ME THIS 14TH DAY OF AUGUST, 1957

Mildred Hobbie

NOTARY PUBLIC

MILDRED HOBBIIE
MY COMMISSION EXPIRES MARCH 6, 1958

PLUGGING			
FILE	SEC	T	R
	16	22	13W
BOOK	PAGE	LINE	
	37	19	

RECEIVED
STATE CORPORATION COMMISSION

AUG 23 1957

CONS - VARIOUS DIVISION