


STATE OF KANSAS
STATE CORPORATION COMMISSION

WELL PLUGGING RECORD

Give All Information Completely
Make Required Affidavit
Mail or Deliver Report to
Conservation Division
State Corporation Comm.
245 North Water
Wichita, KS 67202

Stafford County, Sec. 16 Twp 22 Rge. 13 E/W
Location as "NE/CNW 1/4 SW 1/4" or footage from lines

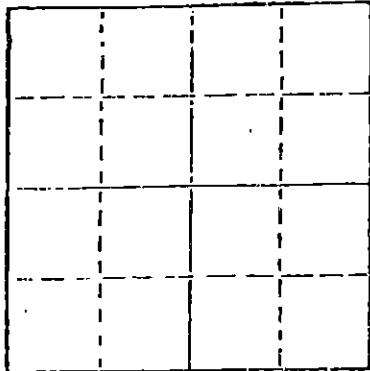

Locate well correctly on above
Section Plot

NW SW NW
Lease Owner Graves Drilling Co., Inc.
Lease Name Grubbs Well No. 1
Office Address 910 Union Center, Wichita, Kansas 67202
Character of Well (Completed as Oil, Gas or Dry Hole)
Dry Hole

Date Well completed October 2 19 80
Application for plugging filed October 2 19 80
Application for plugging approved October 2 19 80
Plugging commenced October 2 19 80
Plugging completed October 2 19 80
Reason for abandonment of well or producing formation

D & A
If a producing well is abandoned, date of last production 19.

Was permission obtained from the Conservation Division or its agents before plugging was commenced? yes

Name of Conservation Agent who supervised plugging of this well Bill Owens
Producing formation Depth to top Bottom Total Depth of Well 3825
Show depth and thickness of all water, oil and gas formations.

OIL, GAS OR WATER RECORDS

CASING RECORD

FORMATION	CONTENT	FROM	TO	SIZE	PUT IN	PULLED OUT

Describe in detail the manner in which the well was plugged, indicating where the mud fluid was placed and the method or methods used in introducing it into the hold. If cement or other plugs were used, state the character of same and depth placed, from feet to feet for each plug-set.

1st plug @ 360' w/50 sacks cement
Mud to 40' w/1/2 sack hulls
Bridge plug and 10 sacks cement
10 sacks in rat hole

(If additional description is necessary, use BACK of this sheet)

Name of Plugging Contractor Mustang Drilling, Inc.


STATE OF KANSAS COUNTY OF BARTON, ss.
Milford Martin (employee of owner) or (owner or operator)
of the above-described well, being first duly sworn on oath, says: That I have knowledge of the facts, statements, and matters herein contained and the log of the above-described well as filed and that the same are true and correct. So help me God.

(Signature) *Milford Martin*

Box 1425, Great Bend, Kansas 67530
(Address)

SUBSCRIBED AND SWORN TO before me this 15th day of October, 1980

My commission expires

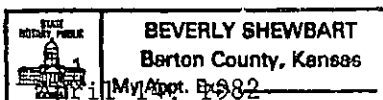

Beverly Shewbart
Notary Public.

10-17-80

RECEIVED
STATE CORPORATION COMMISSION
OCT 17 1980
CONSERVATION DIVISION
Wichita, Kansas

DRILLERS' WELL LOG

DATE COMMENCED: September 25, 1980
 DATE COMPLETED: October 2, 1980

Graves Drilling Co., Inc.
 GRUBBS # 1
 NW SW NW
 Sec 16-T22-R13W
 Stafford County, Kansas

ELEVATION: 1904 K.B.

0 - 150' Sand, Surface Clay
 150 - 362' Sand, Red Bed
 362 - 720' Red Bed, Shale
 720 - 1790' Shale
 1790 - 2930' Shale, Lime
 2930 - 3272' Lime, Sahle
 3272 - 3776' Shale
 3776 - 3419' Lime, Shale
 3419 - 3760' Lime
 3760 - 3815' Shale
 3815 - 3825' Dolomite
 3825' RTD

FORMATION TOPS	
Anhydrite	765
Heebner	3272
Brown Lime	3401
Lansing	3419
Viola	3722
Simpson Shale	3760
Arbuckle	3815
RTD	3825

SURFACE PIPE:
 Set used 8 5/8", 24# pipe
 @ 356' w/250 sacks Common,
 2% Gel, 3% cc.

A F F I D A V I T

STATE OF KANSAS)
 COUNTY OF BARTON) ss.

I, Milford Martin, of Mustang Drilling, Inc. do state that the above is true and correct to the best of my knowledge.

Milford Martin

 Milford Martin

Subscribed and sworn to before me this 3rd day of October, 1980.

STATE NOTARY PUBLIC
BEVERLY SHEWBART
 Barton County, Kansas
 My Appt. Exp. April 14, 1982

My Commission Expires: April 14, 1982

RECEIVED
 STATE CORPORATION COMMISSION
Beverly Shewbart
 Notary Public OCT - 6 1980

CONSERVATION DIVISION
 Wichita, Kansas