


STATE OF KANSAS  
STATE CORPORATION COMMISSION

WELL PLUGGING RECORD

Give All Information Completely  
Make Required Affidavit  
Mail or Deliver Report to:  
Conservation Division  
State Corporation Commission  
211 No. Broadway  
Wichita, Kansas

NORTH

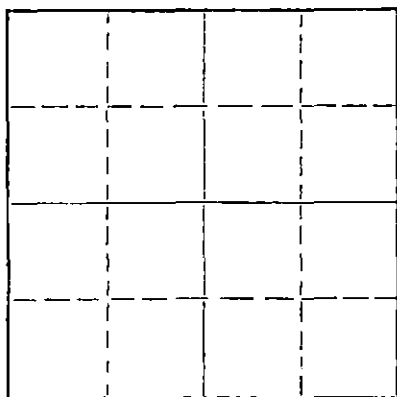

Locate well correctly on above  
Section Plat

Stafford County. Sec. 16 Twp. 22S Rge. 13W (E) --- (W)  
Location as "NE/CNW/SE/SW" or footage from lines C E/2 SE/4 SE/4  
Lease Owner E. K. Edmiston  
Lease Name Curtis Well No. -3-  
Office Address 501 First National Bank Bldg., Wichita, Ks.  
Character of Well (completed as Oil, Gas or Dry Hole) dry hole  
Date well completed May 26, 1965 19  
Application for plugging filed May 26, 1965 19  
Application for plugging approved May 26, 1965 19  
Plugging commenced May 26, 1965 19  
Plugging completed May 26, 1965 19  
Reason for abandonment of well or producing formation dry hole

If a producing well is abandoned, date of last production --- 19  
Was permission obtained from the Conservation Division or its agents before plugging was commenced? yes

Name of Conservation Agent who supervised plugging of this well A. Elving  
Producing formation --- Depth to top --- Bottom --- Total Depth of Well 3841 Feet  
Show depth and thickness of all water, oil and gas formations.

OIL, GAS OR WATER RECORDS

CASING RECORD

FORMATION	CONTENT	FROM	TO	SIZE	PUT IN	PULLED OUT
				8-5/8"	275'	---

Describe in detail the manner in which the well was plugged, indicating where the mud fluid was placed and the method or methods used in introducing it into the hole. If cement or other plugs were used, state the character of same and depth placed, from \_\_\_\_\_ feet to \_\_\_\_\_ feet for each plug set.

heavy mud/260 1/4 hulls plug and 25 sacks cement  
heavy mud to 40 feet

RECEIVED  
STATE CORPORATION COMMISSION

JUN 2 1965

6-2-65  
CONSERVATION DIVISION  
Wichita, Kansas

(If additional description is necessary, use BACK of this sheet.)  
Name of Plugging Contractor E. K. Edmiston Drilling Co., Inc.  
Address 501 First National Bank Building, Wichita, Kansas

STATE OF KANSAS, COUNTY OF SEDGWICK, ss.  
E. K. Edmiston (~~employee of owner~~) or (owner or operator) of the above-described well, being first duly sworn on oath, says: That I have knowledge of the facts, statements, and matters herein contained and the log of the above-described well as filed and that the same are true and correct. So help me God.

(Signature) [Signature]  
E. K. Edmiston  
501 First National Bank Bldg., Wichita, Ks  
(Address)

SUBSCRIBED AND SWORN TO before me this 1st day of June, 1965

My commission expires August 25, 1968 A. B. Barger Notary Public.

D R I L L E R ' S            L O G

Company: E. K. Edmiston  
501 First National Bank Building  
Wichita, Kansas 67202

Rotary Drilling Commenced: May 17, 1965

Rotary Drilling Completed: May 26, 1965

Well Name: CURTIS No. 3  
C E/2 SE/4 SE/4 16-22S-13W  
Stafford County, Kansas

Contractor: E. K. Edmiston Drilling Co., Inc.  
501 First National Bank Building  
Wichita, Kansas 67202

Casing Record: 275' of 8-5/8" with 250 sacks cement

L O G

Measurements from top of Kelly Bushing

Sand and Shale	0 - 275
Red Bed Shale	528
Shale Red Bed	747
Anhydrite	775
Shale and Shells	1135
Shale and Lime	1695
Lime and Shale	2261
Shale and Lime Streaks	2510
Shale and Lime	2899
Lime and Shale	3315
Lime	3725
Chert	3771
Chert and Lime	3841 RTD

RECEIVED  
STATE CORPORATION COMMISSION

0 - 275 JUN 2 1965

CONSERVATION DIVISION  
Wichita, Kansas

The undersigned, E. K. EDMISTON, President of E. K. Edmiston Drilling Co., Inc., hereby certifies on behalf of said company, that the above log is a true and correct log of the formations encountered in drilling the above well, as reflected by the daily drilling reports.


E. K. EDMISTON DRILLING CO., INC.

By   
E. K. Edmiston, President

STATE OF KANSAS,  
SS:  
SEDGWICK COUNTY,

BE IT REMEMBERED that on this 1st day of June, 1965, before me, the undersigned, a Notary Public within and for the County and State aforesaid, came E. K. EDMISTON, known to me to be the same person who executed the foregoing instrument as President and on behalf of the E. K. Edmiston Drilling Co., Inc., and he duly acknowledged the execution of the same for himself and for said company.

IN WITNESS WHEREOF, I have hereunto set my hand and official seal on the day and year last above written.

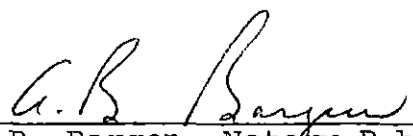  
A. B. Bargaen, Notary Public

My commission expires  
August 25, 1968