


Give All Information Completely
Make Required Affidavit
Mail of Deliver Report to:
Conservation Division
State Corporation Commission
800 Bittling Building
Wichita, Kansas

WELL PLUGGING RECORD

15.185-00111-0000

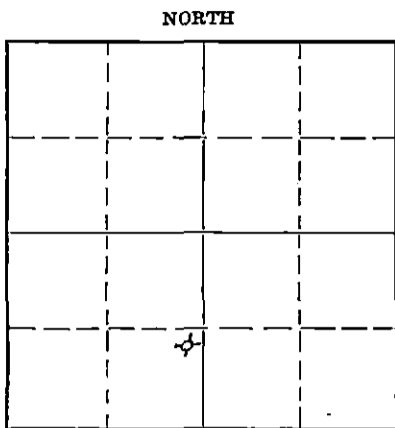

Locate well correctly on above Section Flat

Stafford County. Sec. 9 Twp. 22 Rge. 12 (E) (W)
Location as "NE/CNW $\frac{1}{4}$ /SW $\frac{1}{4}$ " or footage from lines NE SE SW
Lease Owner R. E. Welch
Lease Name Teichmann Well No. 1
Office Address 1017 Union Nat'l Bank Bldg., Wichita, Kans
Character of Well (completed as Oil, Gas or Dry Hole) D & A
Date well completed January 8 19 53
Application for plugging filed January 8 19 53
Application for plugging approved January 8 19 53
Plugging commenced January 8 19 53
Plugging completed January 8 19 53
Reason for abandonment of well or producing formation Non-productive
If a producing well is abandoned, date of last production none 19
Was permission obtained from the Conservation Division or its agents before plugging was commenced? Yes

Name of Conservation Agent who supervised plugging of this well M. A. Rives
Producing formation Depth to top Bottom Total Depth of Well 3690 Feet
Show depth and thickness of all water, oil and gas formations.

OIL, GAS OR WATER RECORDS

CASING RECORD

Formation	Content	From	To	Size	Put In	Pulled Out
				8-5/8"	225'	Cemented

Describe in detail the manner in which the well was plugged, indicating where the mud fluid was placed and the method or methods used in introducing it into the hole. If cement or other plugs were used, state the character of same and depth placed, from feet to feet for each plug set.

Heavy mud from 3690', total depth, to 210'.
Set solid plug and 20 sacks of cement.
Heavy mud to 35'. Set another solid plug
and 10 sacks of cement.

(If additional description is necessary, use BACK of this sheet)

Correspondence regarding this well should be addressed to Welch & Olsson Oil Co.
Address 1017 Union Nat'l Bank Bldg., Wichita, Kansas

STATE OF Kansas, COUNTY OF Sedgwick, ss.
R. E. Welch (employee of owner) or (owner or operator) of the above-described well,

being first duly sworn on oath, says: That I have knowledge of the facts, statements, and matters herein contained and the log of the above-described well as filed and that the same are true and correct. So help me God.

(Signature) *[Handwritten Signature]*
1017 Union Nat'l Bank Bldg (Address)

SUBSCRIBED AND SWORN TO before me this 14th day of Jan, 1953

My commission expires May 27, 1953

[Handwritten Signature]
Notary Public.

23-3273-8 4-50-10M

PLUGGING
FILE SEC 9 T 22 R 12 W
BOOK PAGE 72 LINE 3

FED 4-1953 2-4-53
CONSERVATION DIVISION
Wichita, Kansas

COMPANY Welch & Olsson Oil Company
237 South Main Street
Wichita, Kansas

Rotary Drilling Comm: 12-26-52
Rotary Drilling Comp: 1-8-53

LOCATION: Teichmann #1 NE SE SW
Sec. 9-22S-12W Stafford County, Kansas

CONTRACTOR: Shelley-Miller Drilling, Inc.
Wichita, Kansas

CASING RECORD: 8 5/8" Casing, set at 225 feet, cemented
with 200 sacks cement

LOG

(Figures indicate bottom formation, measurements from top rotary bushing)

Sandy Shale	212
Shale	225
Red Bed & Shale	658
Anhydrite	687
Shale	700
Shale & Shells	1500
Lime	2085
Lime & Shale	2325
Shale	2490
Shale & Shells	2650
Shells, Shale & Lime	2790
Lime & Shale	2875
Lime	3170
Lime & Shale	3330
Lime	3565
Lime & Shale	3620
Lime	3689 Rotary T. D.

The undersigned, Richard A. Shelley, President of Shelley-Miller Drilling, Inc., hereby certifies in behalf of said company, that the above log is a true and correct log of the formation encountered in drilling the above well as reflected by the Daily Drilling Reports.

SHELLEY-MILLER DRILLING, INC.

By Richard A. Shelley
President

RECEIVED
STATE CORPORATION COMMISSION

FEB 4 - 1953

CONSERVATION DIVISION

STATE OF KANSAS)
COUNTY OF SEDGWICK) SS:

BE IT REMEMBERED that on this 15th day of January, 1953, before me, the undersigned, a Notary Public, duly commissioned in and for the county and state aforesaid, came Richard A. Shelley, President, and known to me to be the same person who executed the foregoing instrument of writing in behalf of Shelley-Miller Drilling, Inc., as President of said company, and he duly acknowledged the execution of the same for himself and for said company.

IN WITNESS WHEREOF, I have hereunto set my hand and official seal on the day and year last above written.

W. J. [Signature]
Notary Public

My commission expires:

March 19, 1953