


WELL PLUGGING RECORD

Give All Information Completely
Make Required Affidavit
Mail or Deliver Report to:
Conservation Division
State Corporation Commission
800 Bittling Building
Wichita, Kansas

NORTH

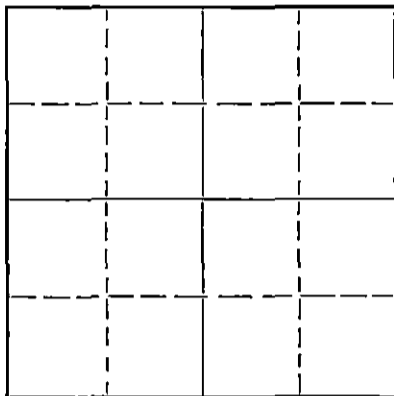

Locate well correctly on above Section Plat

Stafford County, Sec. 9 Twp. 22 Rge. 12 (E) W (W)
Location as "NE/CNW $\frac{1}{4}$ SW $\frac{1}{4}$ " or footage from lines NW NW SW

Lease Owner Bishop Oil Company

Lease Name Teichmann Well No. 1

Office Address 316 Brown Bldg., Wichita, Kansas

Character of Well (completed as Oil, Gas or Dry Hole) Oil

Date well completed 1-13 19 48

Application for plugging filed 3-22 19 51

Application for plugging approved 19

Plugging commenced 5-8 19 51

Plugging completed 5-10 19 51

Reason for abandonment of well or producing formation No longer commercially productive.

If a producing well is abandoned, date of last production 19

Was permission obtained from the Conservation Division or its agents before plugging was commenced? Yes

Name of Conservation Agent who supervised plugging of this well Stough

Producing formation Arbuckle Depth to top 3691 Bottom 3693 Total Depth of Well 3693 Feet

Show depth and thickness of all water, oil and gas formations.

OIL, GAS OR WATER RECORDS

CASING RECORD

Formation	Content	From	To	Size	Put In	Pulled Out
Arbuckle	Oil	3691	3693	5 $\frac{1}{2}$ "	3691	2847

Describe in detail the manner in which the well was plugged, indicating where the mud fluid was placed and the method or methods used in introducing it into the hole. If cement or other plugs were used, state the character of same and depth placed, from feet to feet for each plug set.

Rocked hole from 3700' to 3690' and ran 5 sacks cement. Mudded hole to 260', set 10' rock bridge and ran 15 sacks cement. Mudded hole to 35' and ran 10 sacks cement on top. Plugging completed.

RECEIVED
STATE CORPORATION COMMISSION
MAY 23 1951
CONSERVATION DIVISION
Wichita, Kansas
5-23-51

(If additional description is necessary, use BACK of this sheet)
Correspondence regarding this well should be addressed to Bishop Oil Company
Address 316 Brown Bldg., Wichita, Kansas

STATE OF _____, COUNTY OF _____, ss.

_____ (employee of owner) or (owner or operator) of the above-described well, being first duly sworn on oath, says: That I have knowledge of the facts, statements, and matters herein contained and the log of the above-described well as filed and that the same are true and correct. So help me God.

(Signature) Donald J. Paulsen
Chief Geol. - Mid. Cont. Area
(Address)

SUBSCRIBED AND SWORN TO before me this 22 day of May, 1951.

My commission expires 3/27/54 _____ Notary Public.

PLUGGING
FILE SEC 9 T 22 R 12 W
BOOK PAGE 79 LINE 38

TEICHMANN WELL NO. 1

Casing Record: 8 5/8" - 294' 5" - 3691'	Company: Bishop Oil Co. and Aylward Drilling Co.	Location: NW 1/4 NW 1/4 SW 1/4 Sec. 9-22S-12W, Stafford County, Kansas
	Contractor: Aylward Drilling Co.	Elevation: 1873'
	Commenced: December 22, 1948	Potential:
	Completed: January 7, 1949	

	<u>From</u>	<u>To</u>	<u>REMARKS</u>
Surface clay	0	40	
Sand	40	200	
Shale	200	294	Set 8 5/8" casing at 294' & cemented with 175 sacks
Red Bed	294	340	
Red bed & shale & streaks of sand	340	525	
Shale and shells	525	672	
Anhydrite	672	698	
Shale & shells	698	1585	
Lime and shale	1585	1635	
Gypsie lime and shale	1635	1770	
Lime, sandy	1770	1785	
Lime and shale	1785	1910	
Lime, broken	1910	1930	
Shale and shells	1930	2025	
Lime and shale	2025	2240	
Shale and lime shells	2240	2380	
Lime and shale	2380	2480	
Shale & broken lime	2480	2590	
Lime and shale	2590	2845	
Shale	2845	2880	
Lime	2880	2920	
Lime broken	2920	2930	
Lime and chert	2930	3000	
Shale and lime	3000	3075	
Lime	3075	3205	
Lime and shale	3205	3289	
Shale	3289	3312	
Lime	3312	3593	
Lime and chert	3593	3624	
Shale	3624	3635	
Shale and cherty lime	3635	3665	
Lime	3665	3685	
Sandy shale	3685	3691	
Arbuckle	3691	3694	Set 5 1/2" casing at 3691 and cemented with 125 sacks. Oil filled up 900' in 17 hrs; acidized w/500 gals; tested 12 bbls per hr; 3275' in hole in 14 hrs.
Total depth		3694	

I certify that this is a true and correct copy of the above log, to the best of my knowledge.

Donald I. Lawless
Donald I. Lawless

Subscribed and sworn to before me
this 21 day of March, 1951

John H. ...
NOTARY PUBLIC

My Comm. Expires 3/27/52

PLUGGING
FILE SEC 9 TTY R (XW)
BOOK PAGE 79 LINE 38