


STATE OF KANSAS  
STATE CORPORATION COMMISSION

WELL PLUGGING RECORD

Give All Information Completely  
Make Required Affidavit  
Mail or Deliver Report to:  
Conservation Division  
State Corporation Commission  
800 Bittling Building  
Wichita, Kansas

Stafford County. Sec. 9 Twp. 22 Rge. 12 (E) W(W)  
Location as "NE/CNW $\frac{1}{4}$ SW $\frac{1}{4}$ " or footage from lines NW NW NW  
Lease Owner Harms & Knight Drlg. Co. Prod. Dept.  
Lease Name Teichman Well No. 1  
Office Address Great Bend, Kansas  
Character of Well (completed as Oil, Gas or Dry Hole) Dry Hole  
Date well completed 2-4 19 52  
Application for plugging filed 2-4 19 52  
Application for plugging approved 2-4 19 52  
Plugging commenced 2-4 19 52  
Plugging completed 2-4 19 52  
Reason for abandonment of well or producing formation Dry  
If a producing well is abandoned, date of last production 19  
Was permission obtained from the Conservation Division or its agents before plugging was commenced? Yes

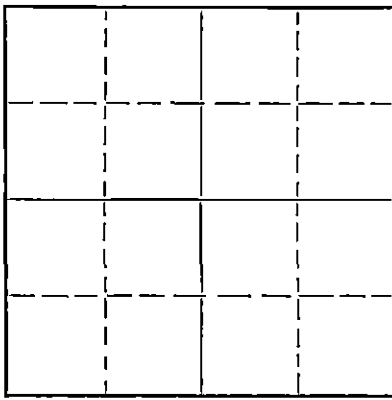

Locate well correctly on above  
Section Plat

Name of Conservation Agent who supervised plugging of this well C. D. Stough  
Producing formation Depth to top Bottom Total Depth of Well 3707 Feet  
Show depth and thickness of all water, oil and gas formations.

OIL, GAS OR WATER RECORDS

CASING RECORD

Formation	Content	From	To	Size	Put In	Pulled Out
		0	307'	8 5/8"	1-19-52	

Describe in detail the manner in which the well was plugged, indicating where the mud fluid was placed and the method or methods used in introducing it into the hole. If cement or other plugs were used, state the character of same and depth placed, from feet to feet for each plug set.

Filled hole with heavy mud.  
Set Bottom plug @ 300' cemented with  
15 sacks bulk cement  
Set Top Plug @ 40' cemented with  
10 sacks bulk cement

2-29-52

(If additional description is necessary, use BACK of this sheet)

Correspondence regarding this well should be addressed to Harms & Knight Drilling Co.  
Address Great Bend, Kansas

STATE OF Kansas, COUNTY OF Barton, ss.

L. C. Knight (employee of owner) or (owner or operator) of the above-described well, being first duly sworn on oath, says: That I have knowledge of the facts, statements, and matters herein contained and the log of the above-described well as filed and that the same are true and correct. So help me God.

(Signature) L. C. Knight  
Great Bend, Kansas (Address)

SUBSCRIBED AND SWORN TO before me this 28<sup>th</sup> day of February, 19 52.

Chatter J. Volk  
Notary Public.

My commission expires September 15, 1952

PLUGGING  
FILE SSC-9-T-22 R-120  
BACK PAGE 14 LINE 29

## WELL LOG

Harms & Knight Drilling Co. Prod. Dept.  
Great Bend, Kansas

Lease: Teichmann  
Well No: 1

NW NW NW  
Sec. 9-22-12W  
Stafford County, Kansas

Total Depth: 3707 T. D.  
Comm: 1-18-52 Comp: 2-4-52  
Contractor: Harms & Knight Drlg. Co.  
Rotary: 0-3707'

Elevation:  
Production: Dry

Casing Record: 8 5/8" set @ 307' cemented w/200 sacks bulk cement, circulated.

Figures indicate bottom of formations:

Sand & Clay	240'
Red Bed	307'
Red Bed & Sand	520'
Red Bed & Shale	667'
Anhydrite	688'
Red Bed & Shale	950'
Shale	1180'
Salt	1380'
Shale	1430'
Shale & Shells	1635'
Shale & Lime	2095'
Shale & Shells	2300'
Shale & Lime	2455'
Shale	2600'
Shale & Shells	2740'
Shale & Lime	3536'
Lime	3639'
Lime & Shale	3707'

We hereby certify this to be a correct and accurate log of the above described well as shown on the daily drilling reports.

HARMS & KNIGHT DRILLING CO.

By: *L. P. Knight*

Subscribed and sworn to before me this 28<sup>th</sup> day of February, 1952

*Walter J. Volk*  
Notary Public

My Commission Expires:

*September 15, 1952*

FILE NO. 9-22-12W  
PAGE 17 LINE 28