


STATE OF KANSAS
STATE CORPORATION COMMISSION

Give All Information Completely
Make Required Affidavit
Mail or Deliver Report to:
Conservation Division
State Corporation Commission
212 North Market, Insurance Bldg.
Wichita, Kansas

WELL PLUGGING RECORD

NORTH

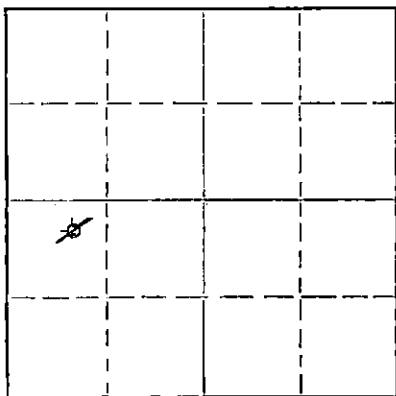

Locate well correctly on above
Section Plot

Stafford County, Sec. 9 Twp. 22 Rge. 12 (E) (W)
Location as "NE/CNW/SW" or footage from lines NE NW SW
Lease Owner C-G Drilling Company
Lease Name Teichman Well No. # 1
Office Address P O Box 637 Plainville, Kansas
Character of Well (completed as Oil, Gas or Dry Hole) _____
Date well completed _____ 19____
Application for plugging filed yes 19____
Application for plugging approved yes 19____
Plugging commenced 1-17-61 19____
Plugging completed 1-21-61 19____
Reason for abandonment of well or producing formation No longer commercial

If a producing well is abandoned, date of last production: December 31, 1960
Was permission obtained from the Conservation Division or its agents before plugging was commenced? yes

Name of Conservation Agent who supervised plugging of this well Frank Broadfoot
Producing formation _____ Depth to top _____ Bottom _____ Total Depth of Well 3681' Feet
Show depth and thickness of all water, oil and gas formations.

OIL, GAS OR WATER RECORDS

CASING RECORD

FORMATION	CONTENT	FROM	TO	SIZE	PUT IN	PULLED OUT
				5 1/2"	3675 1/2	2,818'
				8 5/8"	278.76	None

Describe in detail the manner in which the well was plugged, indicating where the mud fluid was placed and the method or methods used in introducing it into the hole. If cement or other plugs were used, state the character of same and depth placed, from _____ feet to _____ feet for each plug set.

Plugging commenced 1-17-61. Plugging completed 1-21-61.
Measured in to total depth: 3681'.
Plugged off bottom: Sanded back from 3681' to 3660' and dumped 5sacks of cement.
Worked and shot casing: Worked and shot 5 1/2" casing free at 2,818'. Built rack and slide. Pulled and layed down casing.
Plugged well: Mudded hole up to 278' and set 10' rock bridge and dumped 20 sacks of cement. Mudded hole up to 35' and set 10' rock bridge and capped the well with 10 sacks of cement.

STATE OF KANSAS
Conservation Division
Wichita, Kansas
61
2-3-61

(If additional description is necessary, use BACK of this sheet)
Name of Plugging Contractor J. O. Forbes d/b/a Forbes Casing Pulling Co.
Address P O Box 221 Great Bend, Kansas

STATE OF Kansas, COUNTY OF Barton, ss.
J. O. Forbes (employee of owner) or (owner or operator) of the above-described well, being first duly sworn on oath, says: That I have knowledge of the facts, statements, and matters herein contained and the log of the above-described well as filed and that the same are true and correct. So help me God.

(Signature) J. O. Forbes
Great Bend, Kansas
(Address)

SUBSCRIBED AND SWORN TO before me this 23rd day of January, 19 61

My commission expires: December 8th, 1963

Kayann Jenkins
Notary Public.

W E L L L O G

OPERATOR C-G Drilling Co. SEC. 9-22S-12W
 WELL NAME Teichmann LOC. NE NW SW
 TOTAL DEPTH 3679' COUNTY Stafford
 DRLG. DRLG. STATE Kansas
 COMM. October 28, 1959 COMP. November 8, 1959
 DRY & ABANDONED January 21, 1961 ELEVATION 1869' K.B.
 RIG NO. 1

LEFT IN HOLE: 278.76' (7jts.) 8-5/8" OD Surface PRODUCTION: Abandoned
 Casing.
 857 1/2' 5-1/2" OD Casing @3675 1/2'
 (114 jts.)

All measurements taken from the top of rotary bushing.

FROM	TO	FORMATION	DEVIATION FROM VERTICAL	REMARKS:
0	220	Sand		
220	668	Red Bed		
668	700	Anhydrite		
700	1435	Shale-Shell		
1435	1796	Shale-Lime		
1796	1930	Lime-Shale	0° - 2500	DST 3346-3394'
1930	2980	Shale-Lime	0° - 2750	DST 3416-3469'
2980	3677	Lime	0° - 3000	DST 3472-3508'
3677	3679	Arbuckle	0° - 3250	DST 3676-3679'

RECORDED
 STATE CORPORATION COMMISSION

FEB 11 1961

CONSERVATION DIVISION
 Wichita, Kansas

STATE OF KANSAS }
 COUNTY OF SEDGWICK } SS.

The undersigned hereby certifies that to the best of his knowledge and belief, the above facts are true and correct.

C-G DRILLING CO.

By G. F. Galloway
 G. F. Galloway

SUBSCRIBED AND SWORN TO, BEFORE ME, THIS 1st day of February, 1961.

My commission expires:
 May 20, 1963

Vicky Jacobs
 Vicky Jacobs - Notary public

