


STATE OF KANSAS
STATE CORPORATION COMMISSION

Give All Information Completely
Make Required Affidavit
Mail or Deliver Report to:
Conservation Division
State Corporation Commission
800 Bittling Building
Wichita, Kansas

NORTH

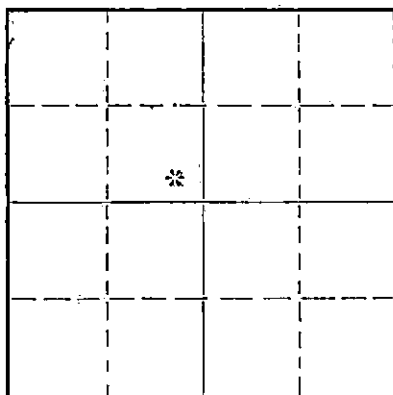

Locate well correctly on above
Section Flat

15.007.30366.00.00
WELL PLUGGING RECORD

Barber County, Sec. 36 Twp. 30 S. Rge. 15 (W)
Location as "NE/CNW $\frac{1}{4}$ SW $\frac{1}{4}$ " or footage from lines 467' N of S line & 467' W of
Lease Owner Great Lakes Carbon Corp. et al E line-NW $\frac{1}{4}$
Lease Name H. F. Hoagland Well No. 1
Office Address 501 Petroleum Bldg., Wichita, Kans.
Character of Well (completed as Oil, Gas or Dry Hole) Dry Hole
Date well completed 8-28-52 19
Application for plugging filed 8-28-52 19
Application for plugging approved 8-28-52 19
Plugging commenced 8-28-52 19
Plugging completed 8-28-52 19
Reason for abandonment of well or producing formation Dry hole

If a producing well is abandoned, date of last production 19
Was permission obtained from the Conservation Division or its agents before plugging was com-
menced? Yes

Name of Conservation Agent who supervised plugging of this well Rives, Pratt, Kansas
Producing formation Depth to top Bottom Total Depth of Well 4428 Feet
Show depth and thickness of all water, oil and gas formations.

OIL, GAS OR WATER RECORDS

CASING RECORD

Formation	Content	From	To	Size	Put In	Pulled Out
None						

Describe in detail the manner in which the well was plugged, indicating where the mud fluid was placed and the method or methods used in introducing it into the hole. If cement or other plugs were used, state the character of same and depth placed, from feet to feet for each plug set.

Heavy drilling mud 4428 - 800
Halliburton plug 800
25 sax cement 800 - 770
Left open for water well 770 - 0

Affidavit from signed by land owner, hole open for water well.

RECEIVED
STATE CORPORATION COMMISSION
SEP 11 1952

CONSERVATION DIVISION
Wichita, Kansas

(If additional description is necessary, use BACK of this sheet)

Correspondence regarding this well should be addressed to Great Lakes Carbon Corporation
Address 501 Petroleum Bldg., Wichita, Kansas. From 4428' to 800', H.F. Hoagland
Sun City, Kansas - 800' to surface.

STATE OF KANSAS, COUNTY OF SEDGWICK, ss.
D.H. Sholtus, Dist. Prod. Supt. (employee of owner) or (owner or operator) of the above-described well,
being first duly sworn on oath, says: That I have knowledge of the facts, statements, and matters herein contained and the log of the above-
described well as filed and that the same are true and correct. So help me God.

(Signature) D.H. Sholtus, Dist. Prod. Supt.
501 Petroleum Bldg., Wichita, Kans.
(Address)

SUBSCRIBED AND SWORN to before me this 10th day of September 19 52

My commission expires January 22, 1955

22-5133-s

9-48-10M

PLUGGING
FILE SEC 36 T 30 R 15
BOOK PAGE 41 LINE 15

RECEIVED
STATE CORPORATION COMMISSION
Notary Public.

SEP 11 1952

CONSERVATION DIVISION
Wichita, Kansas



STATE OF KANSAS
STATE CORPORATION COMMISSION
CONSERVATION DIVISION
800 BITTING BUILDING
WICHITA, KANSAS

AUTHORIZATION

The undersigned, owner of the following described land, to
wit: All of SE 20 acres of NW 1/4 of Sec. 36 Twp. 30S Rge. 15 W
BARBER County, Kansas; hereby requests that
Well No. 1 located in of NW 1/4 of Sec. 36 Twp. 30S Rge. 15 W
be left open above the fresh water protecting bridge set at
800 feet, to be used as a fresh water well and I hereby
authorize GREAT LAKES CARBON CORPORATION, well owner, to
ET AL
so complete the abandonment of said well.

Witnessed by J. H. Pearce W. F. Hoagland
(Land Owner)

Dated at Wichita City, Kansas, this 29 day of
August 1952.

STATE OF KANSAS)
COUNTY OF SEDGWICK) ss.

Helen G. Langston of the CONTINENTAL MAP COMPANY, of Wichita, Kansas being first
duly sworn depose and say; that the above is a true and correct photo-copy of the original
instrument delivered to us.

Subscribed and sworn to before me this 15 day of Sept

My commission expires Oct 17, 1953

CONTINENTAL MAP COMPANY

By Helen G. Langston
1952.

Dorothy M. Barber
NOTARY PUBLIC

15.007.30366.00.00
RECEIVED
STATE CORPORATION COMMISSION
OCT 16 1952

CONSERVATION DIVISION
Wichita, Kansas

Great Lakes Carbon Corporation,
Hoagland Well # 1.
Total Depth 4427 Ft.
Comm. 7/28/52
Comp. 8/29/52
Contractor R. C. Patton Co.,

13.007.30366.00.00
Location: 467' North of South line and
467' West of East line of NW/4
Section 36, T30S, R15W, Barber County,
Kansas.
8 5/8" Casing at 809 Ft.
Cemented with 250 Sacks

Cellar	10
Gip, Shells & Red bed	200
Red Bed & Shells	435
Red Shale & Shells	625
Anhydrite	655
Shale & Shells	1675
Lime Broken	1700
Lime & Shale	2050
Lime	2580
Lime & Shale	3120
Lime	3144
Lime Broken	3162
Lime & Shale	3784
Sand	3797
Lime & Sand 3855	3855
Lime & Shale	3915
Lime	4095
Lime Soft	4102
Lime 4240	4240
Lime & Shale	4284
Lime	4305
Black Shale & Lime	4316
Cored	4337
Lime	4360
Lime & Shale	4410
conglomerate	4427
Total Depth	4427

STATE OF Kansas COUNTY OF Ledgewick ss.

I, the undersigned, being duly sworn, on oath state that the above statement and log is a true and correct record and log of the well drilled at the location above described.

R. C. PATTON CO.,

By R. C. Patton

Subscribed and sworn to before me this 11th day of September 1952.

R. C. Hendrick
Notary Public.

My Commission Expires Oct. 4th 1952.

