


STATE OF KANSAS
STATE CORPORATION COMMISSION

Form CP-4

Give All Information Completely
Make Required Affidavit
Mail or Deliver Report to:
Conservation Division
State Corporation Commission
212 No. Market
Wichita, Kansas

WELL PLUGGING RECORD

NORTH

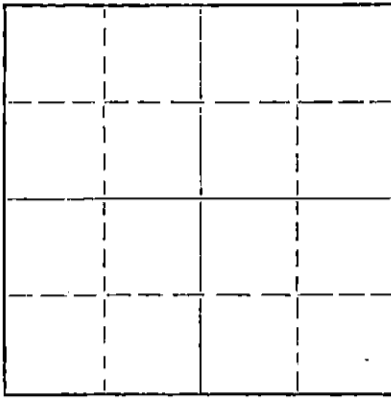

Locate well correctly on above
Section Plat

Stafford County, Sec. 3 Twp. 22S Rge. (E) 12 (W)
Location as "NE/CNW%SW%" or footage from lines NE NW SE
Lease Owner Braden-Deem, Inc.
Lease Name Krankenber Well No. 1
Office Address 210 One Twenty Bldg., Wichita, Kansas
Character of Well (completed as Oil, Gas or Dry Hole) Oil
Date well completed May 15 19 50
Application for plugging filed March 4 19 69
Application for plugging approved March 5 19 69
Plugging commenced March 12 19 69
Plugging completed March 21 19 69
Reason for abandonment of well or producing formation Uneconomic

If a producing well is abandoned, date of last production 19 68
Was permission obtained from the Conservation Division or its agents before plugging was commenced? Yes

Name of Conservation Agent who supervised plugging of this well _____
Producing formation Arbuckle Depth to top 3602 Bottom 3605 Total Depth of Well 3605 Feet
Show depth and thickness of all water, oil and gas formations.

OIL, GAS OR WATER RECORDS

CASING RECORD

FORMATION	CONTENT	FROM	TO	SIZE	PUT IN	PULLED OUT
				8-5/8"	251	None
				5-1/2"	3602	2964.74

Describe in detail the manner in which the well was plugged, indicating where the mud fluid was placed and the method or methods used in introducing it into the hole. If cement or other plugs were used, state the character of same and depth placed, from _____ feet to _____ feet for each plug set.

Sand 3605-3585'
5 sacks cement 3585'
Shot pipe @ 3034 & 2926'
Pulled 2965' 5 1/2" casing
Rock Bridge 170' - 160'
20 sacks cement @ 160'
Mud to 30'
10 sacks cement 30' to 4' below surface
Plugging complete

RECEIVED
STATE CORPORATION COMMISSION
APR 17 1969
CONSERVATION DIVISION
Wichita, Kansas

(If additional description is necessary, use BACK of this sheet)

Name of Plugging Contractor Braden-Deem, Inc.
Address 210 One Twenty Bldg., Wichita, Kansas

STATE OF Kansas, COUNTY OF Sedgwick, ss.
Doy C. Deem (employee of owner) or (manner or operator) of the above-described well, being duly sworn on oath, says: That I have knowledge of the facts, statements, and matters herein contained and the log of the above-described well as filed and that the same are true and correct. So help me God.

(Signature) [Signature]
210 One Twenty Bldg., Wichita, Kansas
(Address)

SUBSCRIBED AND SWORN TO before me this 16 day of April, 1969

My commission expires March 21, 1970

[Signature] Notary Public.

A. S. Ritchie, et al
Production Department
Wichita, Kansas

Krankenbergs #1
NE NW SE $\frac{1}{4}$, 3-22-12W
Stafford County, Kansas

Elevation: 1846 D.F.
Spudded: April 24, 1950
Rotary Completed: May 6, 1950
Cable Tool Completed:
Acid Treatment:
Initial Production:
Contractor: Derby Drilling Company

RECEIVED
STATE CORPORATION COMMISSION
MAR 5 1969
CONSERVATION DIVISION
Wichita, Kansas

CASING RECORD

251' 8-5/8" O.D. Seamless cemented with 170 sacks cement
3602' 5-1/2" O.D. Seamless cemented with 75 sacks cement

DRILLERS LOG

Sand	0 to	110	Shale & shells	2245 to	2335
Shale & shells		251	Shale		2535
Red rock		345	Shale & lime		2690
Shale & shells		626	Lime		2790
Anhydrite		653	Shale		2835
Shale & shells		825	Lime		3125
Shale & salt		1310	Lime & shale		3219
Shale & lime		1635	Shale		3253
Shale, shells & sand		1770	Lime		3532
Lime		1850	Chert		3561
Sand		1880	Lime		3605 T.D.
Lime		2245	T.D. 3605 =	D.F. 3603	

STATE OF KANSAS)
) SS.
COUNTY OF SEDGWICK)

I hereby certify that to the best of my knowledge and belief,
the foregoing log is true and correct.

DERBY DRILLING COMPANY

By M. A. Davis

Subscribed and sworn to before me, a Notary Public, in and for
the State and County aforesaid this 24 day of May, 1950.

Deena Larnish
Notary Public

My Com. Exp. 1/28/53