


STATE OF KANSAS
STATE CORPORATION COMMISSION

Give All Information Completely
Make Required Affidavit
Mail or Deliver Report to:
Conservation Division
State Corporation Commission
211 No. Broadway
Wichita, Kansas

15-055-0055-0000
WELL PLUGGING RECORD

Finney County, Sec. 16 Twp. 21S Rge. 32(W)

Location as "NE/CNW/SW" or footage from lines NW/4
Lease Owner Texaco Inc.
Lease Name G. A. Schreiner Well No. 1
Office Address 614 Bitting Building-Wichita, Kansas
Character of Well (completed as Oil, Gas or Dry Hole) Gas
Date well completed 5-6-1961
Application for plugging filed 2-20-1962
Application for plugging approved 2-26-1962
Plugging commenced 3-9-1962
Plugging completed 3-9-1962
Reason for abandonment of well or producing formation Completed non-commercial

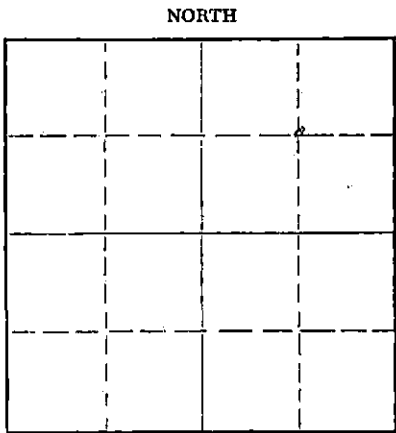

Locate well correctly on above Section Plat

If a producing well is abandoned, date of last production 19
Was permission obtained from the Conservation Division or its agents before plugging was commenced? Yes

Name of Conservation Agent who supervised plugging of this well W. L. Lac Kamp
Producing formation Herrington Depth to top 2672 Bottom Total Depth of Well 2728 Feet
Show depth and thickness of all water, oil and gas formations.

Hollenberg 2645
OIL, GAS OR WATER RECORDS CASING RECORD

FORMATION	CONTENT	FROM	TO	SIZE	PUT IN	PULLED OUT
Krider	NC-G	2645	2672	8-5/8"	218'	(0)
Herrington	NC-G	2672	T.D.	4-1/2"	2732'	(0)

Describe in detail the manner in which the well was plugged, indicating where the mud fluid was placed and the method or methods used in introducing it into the hole. If cement or other plugs were used, state the character of same and depth placed, from feet to feet for each plug set.

Plugged back from 2674-2205 w/30 sx cmt, wtr 2205-650, 60 sx cmt 650-3'.

RECEIVED
STATE CORPORATION COMMISSION
MAR 13 1962
03-16-62
CONSERVATION DIVISION
Wichita


(If additional description is necessary, use BACK of this sheet)
Name of Plugging Contractor None
Address

STATE OF STATE OF KANSAS COUNTY OF SEDGWICK, ss.
M. C. HARRELL, DIST.SUPT. (employee of owner) or (owner or operator) of the above-described well, being first duly sworn on oath, says: That I have knowledge of the facts, statements, and matters herein contained and the log of the above-described well as filed and that the same are true and correct. So help me God.
(Signature) M. C. Harrell
614 Bitting Building-Wichita, Kansas
(Address)

SUBSCRIBED AND SWORN TO before me this 13th day of March, 19 62
A. E. Boyd
My commission expires June 20, 1964 Notary Public.

TEXACO INC.—LOG OF WELL

Field DIVISION

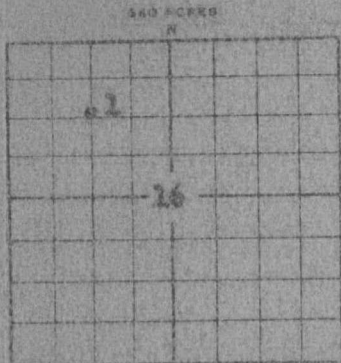

INDICATE EXACT WELL LOCATION & LEASE BOUNDARY WITHIN SECTION

WELL G. A. Schneider No. 1 L. D. FILE NO. 15343A

LOC. Str NW/4 SEC. 16 TWP. 21S RGE. 32W

1320' S & 1320' W of NE Cor of Sec.

DIST. Wichita CO. PARISH Finney STATE Kansas

COMM. DRLG. 4-7-61 COMP. DRLG. 4-12-61 DAYS DRLG. 5

ROT. FROM 0 TO 2728 CABLE FROM " TO "

CONTR. OR CO. RIG NO. Capito Drig. T. D. DRILLED 2728

COMP. T. D. 2728 ZERO ELEV. KB 2918 GRD. ELEV. 2913 CSG. PLG. ELEV. 1911 1/2

DATE OF FIRST PROD. 4-28-61 OFFICIAL COMP. DATE 5-4-61

LOGS RUN Radiation Guard Log

CASING RECORD

SIZE INCHES	DEPTH FEET	WEIGHT 27/FT.	GRADE	RANGE	REMARKS—QUAN. CMT., TEMP. SURV., ETC.
8-5/8	218'	26#	New	2	Set & Cased @ 218' w/125 ex Reg w/10% Jol & 50 ex reg 25 Ca Cl. Cmt. Circ.
4-1/2	2728	9.5#	New	2	Set & Cased @ 2728' w/150 ex Reg, 40% Diesel & 100 ex Pol. MEASUREMENTS fr KB to GL 5', GL to BM 1 1/2' 3 CENTRALIZERS fr 2660 to 2720'. 4 SURATCHERS fr 2640 to 2710'.

COMPLETION DATA

FORMATION	Hurlington	Hollenberg	
DATE OF TEST	5-6-61		
DEPTH OF PROD. INTERVAL	2672-79	2665-60	
INITIAL PRODUCTION:	OIL - BPD		
	GAS - MCF	700	
	WATER - BPD		<i>cc. Per Well Log</i> <i>Julian</i> <i>Lubert</i>
	GOR		
	BHP - PSI		
CORRECTED API GRAVITY			
PRODUCING CONDITIONS		125	
ARTIFICIAL STIMULATION		New Remarks	

REMARKS

1) 2.66
2) 7600⁰⁰
7550⁰⁰
2450⁰⁰

WELL G. A. Schneider No. 1 FIELD Finney AREA Wichita