

15-185-20487-0000


STATE OF KANSAS
STATE CORPORATION COMMISSION

Give All Information Completely
Make Required Affidavit
Mail or Deliver Report to:
Conservation Division
State Corporation Commission

WELL PLUGGING RECORD

P. O. Box 17027
Wichita, Kansas 67217
NORTH

Stafford County, Sec. 35 Twp. 23 Rge. (E) 12(W)
Location as "NE/CNW/SW" or footage from lines SE NW SE
Lease Owner Zetco Petroleum Co., Inc.
Lease Name Kelly Well No. 1
Office Address 357 Lulu
Character of Well (completed as Oil, Gas or Dry Hole) Dry Hole
Date well completed Feb. 12 19 74
Application for plugging filed Feb. 12 19 74
Application for plugging approved Feb. 12 19 74
Plugging commenced Feb. 12 19 74
Plugging completed Feb. 12 19 74
Reason for abandonment of well or producing formation Dry Hole

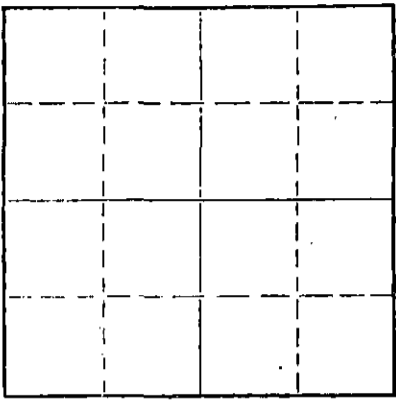

Locate well correctly on above Section Plat

If a producing well is abandoned, date of last production 19...
Was permission obtained from the Conservation Division or its agents before plugging was commenced? Yes

Name of Conservation Agent who supervised plugging of this well G. R. Biberstein
Producing formation _____ Depth to top _____ Bottom _____ Total Depth of Well 3905 Feet
Show depth and thickness of all water, oil and gas formations.

OIL, GAS OR WATER RECORDS				CASING RECORD		
FORMATION	CONTENT	FROM	TO	SIZE	PUT IN	PULLED OUT
				8 5/8	215'	

Describe in detail the manner in which the well was plugged, indicating where the mud fluid was placed and the method or methods used in introducing it into the hole. If cement or other plugs were used, state the character of same and depth placed, from _____ feet to _____ feet for each plug set.

1st plug 500' w/40 sx.
2nd plug 200' w/25 sx.
3rd plug 40' w/15 sx.

RECEIVED
STATE CORPORATION COMMISSION
FEB 19 1974
CONSERVATION DIVISION
Wichita, Kansas

(If additional description is necessary, use BACK of this sheet)
Name of Plugging Contractor Woodman & Tannitti Drilling Company
Address 1008 Union National Bldg., Wichita, Kansas 67202

STATE OF KANSAS COUNTY OF SEDGWICK ss.
K. T. Woodman (employee of owner) or (owner or operator) of the above-described well,

being first duly sworn on oath, says: That I have knowledge of the facts, statements, and matters herein contained and the log of the above-described well as filed and that the same are true and correct. So help me God.

(Signature) K. T. Woodman
1008 Union Nat'l. Bldg.
(Address)

SUBSCRIBED AND SWORN TO before me this 15th day of February, 1974

My commission expires Feb. 11, 1976
Justina Chamberlain Notary Public.

K. T. WOODMAN
RES. PHONE 733-0418
OFF. PHONE 265-7650
WICHITA, KANSAS

D. J. IANNITTI
PHONE 792-2921
GREAT BEND, KANSAS

WOODMAN & IANNITTI DRILLING COMPANY
Rotary Drilling Contractors

1008 UNION NATIONAL BUILDING
WICHITA, KANSAS 67202

15-185-26487-0000

Company;	Zetco Petroleum Co., Inc.
Farm;	#1 Kelly
Location;	SE NW SE
Section;	35-23S-12W
County;	Stafford
Contractor;	Woodman & Iannitti Drilling Co.
Comm;	February 2, 1974
Compl;	February 12, 1974
Total Depth;	3905'
Casing;	8 5/8" @ 215 w/175 sacks
Production;	D & A

Figures Indicate Bottom Of Formations:

40	Surface soil
120	Clay, shale & sand
215	Shale with sand streaks
320	Shale
630	Red Bed
690	Anhy
860	Shale & shells
1450	Shale & salt
1550	Shale & shells
1790	Lime
2170	Lime
2360	Lime & shale
2980	Lime & shale
3256	Lime
3497	Lime
3695	Lime
3750	Lime
3800	Lime & chert
3857	Lime
3905	Lime

RECEIVED
STATE CORPORATION COMMISSION
FEB 19 1974
CONSERVATION DIVISION
Wichita, Kansas

Woodman & Iannitti Drilling Co.

K. T. Woodman
K. T. Woodman