


STATE OF KANSAS
STATE CORPORATION COMMISSION

15-055-00021-0000
WELL PLUGGING RECORD

Give All Information Completely
Make Required Affidavit
Mail or Deliver Report to:
Conservation Division
State Corporation Commission
211 No. Broadway
Wichita, Kansas

Finney County. Sec. 11 Twp. 21S Rge. #27 (W)

NORTH

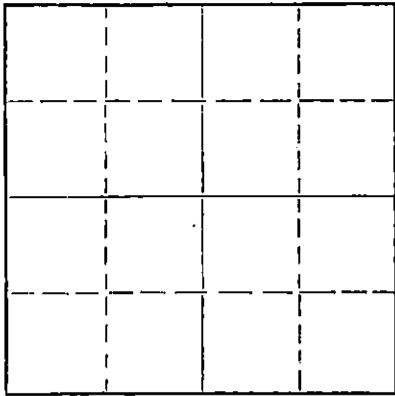

Locate well correctly on above
Section Plat

Location as "NE/CNW/SW" or footage from lines NE NE NW
Lease Owner pickrell Drilling Company
Lease Name Hamill A-1 Well No. 1
Office Address 705 Fourth National Bank Bldg.
Character of Well (completed as Oil, Gas or Dry Hole) Dry Hole
Date well completed December 16, 19 57
Application for plugging filed December 16, 19 57
Application for plugging approved December 16, 19 57
Plugging commenced December 16, 19 57
Plugging completed December 17, 19 57
Reason for abandonment of well or producing formation D & A

If a producing well is abandoned, date of last production 19
Was permission obtained from the Conservation Division or its agents before plugging was commenced? Yes

Name of Conservation Agent who supervised plugging of this well M. A. Rives
Producing formation _____ Depth to top _____ Bottom _____ Total Depth of Well 4770 Feet
Show depth and thickness of all water, oil and gas formations.

OIL, GAS OR WATER RECORDS

CASING RECORD

FORMATION	CONTENT	FROM	TO	SIZE	PUT IN	PULLED OUT
				8 5/8"	480'	None

Describe in detail the manner in which the well was plugged, indicating where the mud fluid was placed and the method or methods used in introducing it into the hole. If cement or other plugs were used, state the character of same and depth placed, from _____ feet to _____ feet for each plug set.

Filled with heavy mud to 500', bridge hole and Globe Oilwell Cementing, Inc. of Great Bend, Kansas cemented from 500' to 440' with 20 sacks cement. From 440' to base of cellar is open/hole and turned over to landowner. cased

RECEIVED
COMMISSION
JAN 4 1958
CONSERVATION DIVISION
Wichita, Kansas

(If additional description is necessary, use BACK of this sheet)
Name of Plugging Contractor Garvey Drilling Company
Address 311 East Third, Wichita, Kansas

STATE OF Kansas, COUNTY OF Sedgwick, ss.
C. W. Sebitts (owner or operator) of the above-described well, being first duly sworn on oath, says: That I have knowledge of the facts, statements, and matters herein contained and the log of the above-described well as filed and that the same are true and correct. So help me God.

(Signature) [Signature]
705 Fourth National Bank Bldg.
(Address)

SUBSCRIBED AND SWORN TO before me this 23rd day of December, 19 57

My commission expires July 30, 1958

[Signature]
Notary Public.

PLUGGING
FILE SEC 11 T 21 R 27W
BOOK PAGE 70 LINE 7

WELL LOG

COMPANY PICKRELL DRILLING COMPANY

SEC. 11 T. 21S R. 27W

FARM HAMILL "A" NO. 1


LOC. NE, NE, NW

TOTAL DEPTH 4770'

COUNTY FINNEY CO., KANSAS

COMM. November 28, 1957 COMP. December 16, 1957

CONTRACTOR GARVEY DRILLING COMPANY

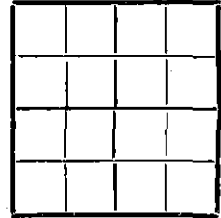

CASING 8 5/8" @ 476' W/275 sax.

ELEVATION 2695' DF

PRODUCTION D & A

FIGURES INDICATE BOTTOM OF FORMATIONS

185	Chalky rock
476	Blue Shale
750	Shale & sand
1325	Shale
1345	Anhydrite
1750	Shale & shells
2340	Shale
2590	Shale & shells
2830	Shale
3885	Lime & shale
3945	Lime
4029	Lime & shale
4208	Lime
4225	Chalky lime
4770	Lime
4770	T. D.

RECEIVED
STATE CORPORATION COMMISSION
JAN 4 1958
CONSERVATION DIVISION
Wichita, Kansas

DRILLING
SEC 11 T 21 R 27W
BOOK PAGE 70 LINE 7

State of KANSAS }
County of BARTON } ss:

I, VERNE A. MORRIS of GARVEY DRILLING COMPANY

upon oath state that the above and foregoing is a true and correct copy of the log of the #1 Hamill "A" well

Verne A. Morris

Subscribed and sworn to before me this 26th day of December 19 57

My Commission Expires: November 22, 1958

Granfubing
NOTARY PUBLIC

AUTHORIZATION

The undersigned, owner of the following described land, to-wit:

THE WEST HALF OF THE NORTHEAST QUARTER (W/2 NE/4)
and WEST HALF (W/2) Section 11, Township 21 South,
Range 27 West, Finney County, Kansas:

hereby requests that the Hamill No. 1 well located in the NE NE NW of Section 11-21S-27W, be left open above the fresh water protecting bridge set at approximately 476 feet, to be used as a fresh water well and I hereby authorize Pickrell Drilling Company and Max Cohen, well owners, to so complete the abandonment of said well.

It is hereby agreed that the undersigned shall indemnify and save harmless the lease owners against all loss, cost or damage on account of any injury, of whatsoever nature, to property, real or personal, occurring at any time after said lease owners have completed and abandoned the well as above described.

Witnessed by:

Carroll Burtis

R. E. Hamill
R. E. Hamill

Dated at KALIVESTA, Kansas, this 16th day of

DECEMBER, 1957.

RECEIVED
OIL & GAS DIVISION

DEC 19 1957

OIL & GAS DIVISION

WL-66