


Give All Information Completely  
Make Required Affidavit  
Mail or Deliver Report to:  
Conservation Division  
State Corporation Commission  
211 No. Broadway  
Wichita, Kansas

15-055-00078-0001  
WELL PLUGGING RECORD

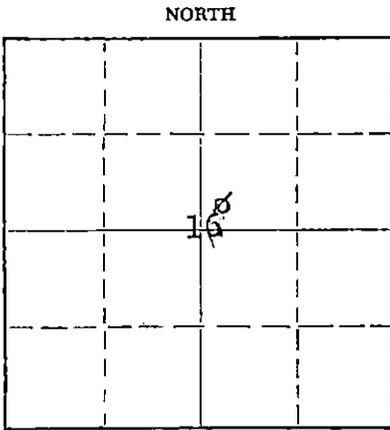

Locate well correctly on above Section Plat

Finney County, Sec. 16 Twp. 21S Rge. (E) 30(W)  
Location as "NE/CNW/SW" or footage from lines C SW SW NE  
Lease Owner A. D. McKelvy  
Lease Name Doll Well No. 16  
Office Address 48 Lloyd Drive, Atherton, California  
Character of Well (completed as Oil, Gas or Dry Hole)  
Date well completed April 24, 1961 19  
Application for plugging filed May 29, 1961 19  
Application for plugging approved Approved by supervisor 4/24/19 61  
Plugging commenced 4/24/61 19  
Plugging completed 4/24/61 We were unable to fish out 19  
Reason for abandonment of well or producing formation junk in hole  
therefore had to abandon and moved 150' north of loc  
If a producing well is abandoned, date of last production 19  
Was permission obtained from the Conservation Division or its agents before plugging was commenced? Yes

Name of Conservation Agent who supervised plugging of this well Frank Broadfoot, St. John, Kansas  
Producing formation \_\_\_\_\_ Depth to top \_\_\_\_\_ Bottom \_\_\_\_\_ Total Depth of Well 3225 Feet  
Show depth and thickness of all water, oil and gas formations.

OIL, GAS OR WATER RECORDS

CASING RECORD

FORMATION	CONTENT	FROM	TO	SIZE	PUT IN	PULLED OUT
	no casing set, washdown					
	- old location.					

Describe in detail the manner in which the well was plugged, indicating where the mud fluid was placed and the method or methods used in introducing it into the hole. If cement or other plugs were used, state the character of same and depth placed, from \_\_\_\_\_ feet to \_\_\_\_\_ feet for each plug set.

Set plug at 300', cemented with 15 sacks cement. Plug at 20', cemented with 15 sacks cement.

RECEIVED  
STATE CORPORATION COMMISSION  
MAY 31 1961 05-31-61  
CONSERVATION DIVISION  
Wichita, Kansas

(If additional description is necessary, use BACK of this sheet)  
Name of Plugging Contractor Graham-Michaelis Drilling Company  
Address 211 North Broadway, Wichita 2, Kansas

STATE OF Kansas, COUNTY OF Sedgwick, ss.  
Jack L. Yinger (employee or owner or operator) of the above-described well, being first duly sworn on oath, says: That I have knowledge of the facts, statements, and matters herein contained and the log of the above-described well as filed and that the same are true and correct. So help me God.

(Signature) Jack L. Yinger Jack L. Yinger  
211 North Broadway, Wichita 2, Kansas  
(Address)

SUBSCRIBED AND SWORN TO before me this 29 day of May 19 61

My commission expires December 12, 1962  
Evelyn D. Evans Notary Public.



DOLL #16

WELL RECORD:

LOCATION:

Section 16-21S-30W  
Finney County, Kansas

Commenced: 4/12/61  
Completed: 5/2/61  
(Rotary)

CONTRACTOR:

Graham-Michaelis Drilling Co.  
Liberal Division  
P. O. Box 896  
Liberal, Kansas

CASING RECORD:

Casing previously set on old hole.

0 - 3256'

LOG  
Washing down old hole, junk in old hole @ 3256', Cement back to 2840' w/100 sx Cement, Drill cement out to 2991' - Abandon hole.

(MOVED RIG 150' NORTHWEST)

CASING RECORD:

11 Joints @ 5/8" 2 1/2" Casing  
Cemented w/200 sx Sunset

	<u>LOG</u>	
Clay, Shale & Chalky Gyp	0 -	650
Shale, Gyp, Clay & Sand	650 -	1135
Shale & Clay	1135 -	1335
Clay, Shale, Sand & Gyp Streaks	1335 -	1785
Red Bed, Shale & Anhy	1785 -	2024
Shale & Lime Streaks	2024 -	2196
Shale, Anhy Streaks & Lime	2196 -	2533
Shale, Lime Streaks & Sandy Dolo.	2533 -	2810
Shale & Sandy Shale	2810 -	2870
Shale & Lime Streaks	2870 -	2980
Lime & Shale	2980 -	3136
Lime Streaks & Shale	3136 -	3200

3200' - Total Rotary Depth

The undersigned, Graham-Michaelis Drilling Company, Liberal Division, certifies that the above log is a true and correct copy of the formations encountered in drilling the above mentioned well, as taken from the Daily Drilling Report.

GRAHAM-MICHAELIS DRILLING COMPANY  
LIBERAL DIVISION

**RECEIVED**  
STATE CORPORATION COMMISSION

MAY 31 1961

CONSERVATION DIVISION  
Wichita, Kansas

By H. R. Michaelis  
H. R. Michaelis