


STATE OF KANSAS
STATE CORPORATION COMMISSION

Give All Information Completely
Make Required Affidavit
Mail or Deliver Report to:
Conservation Division
State Corporation Commission
211 No. Broadway
Wichita, Kansas

15-055-00079-0000
WELL PLUGGING RECORD

NORTH

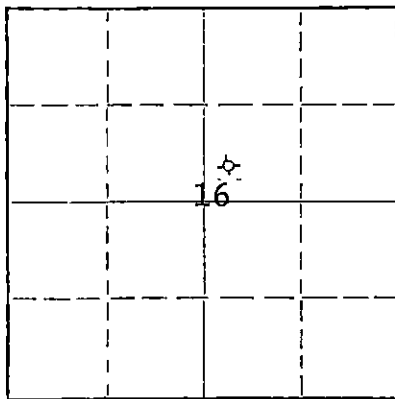

Locate well correctly on above
Section Plat

Finney County. Sec. 16 Twp. 21S Rge. (E) 30(W)
Location as "NE/CNW%SW%" or footage from lines 150' N of C SW SW NE
Lease Owner A. D. McKelvy
Lease Name Doll (Second location) Well No. 16
Office Address 48 Lloyd Drive, Atherton, California
Character of Well (completed as Oil, Gas or Dry Hole) Dry Hole
Date well completed May 2, 19 61
Application for plugging filed May 29, 19 61
Application for plugging approved Approved by supervisor May 1, 19 61
Plugging commenced May 1, 19 61
Plugging completed May 1, 19 61
Reason for abandonment of well or producing formation Dry Hole

If a producing well is abandoned, date of last production 19
Was permission obtained from the Conservation Division or its agents before plugging was commenced? Yes

Name of Conservation Agent who supervised plugging of this well Frank Broadfoot, St. John, Kansas
Producing formation _____ Depth to top _____ Bottom _____ Total Depth of Well 3200' Feet
Show depth and thickness of all water, oil and gas formations.

OIL, GAS OR WATER RECORDS

CASING RECORD

FORMATION	CONTENT	FROM	TO	SIZE	PUT IN	PULLED OUT
				8 5/8"	345'	none

Describe in detail the manner in which the well was plugged, indicating where the mud fluid was placed and the method or methods used in introducing it into the hole. If cement or other plugs were used, state the character of same and depth placed, from _____ feet to _____ feet for each plug set.

Filled hole with mud to 300', set plug with 20 sacks cement.
Filled hole with mud to 35', set plug with 10 sacks cement.

RECEIVED
STATE CORPORATION COMMISSION

05-31-61 MAY 31 1961

CONSERVATION DIVISION
Wichita, Kansas

(If additional description is necessary, use BACK of this sheet)
Name of Plugging Contractor Graham-Michaelis Drilling Company
Address 211 North Broadway, Wichita 2, Kansas

STATE OF Kansas, COUNTY OF Sedgwick, ss.
Jack L. Yinger (employee of ~~Kansas State Corporation~~ operator) of the above-described well, being first duly sworn on oath, says: That I have knowledge of the facts, statements, and matters herein contained and the log of the above-described well as filed and that the same are true and correct. So help me God.

(Signature) Jack L. Yinger Jack L. Yinger
211 North Broadway, Wichita 2, Kansas
(Address)

SUBSCRIBED AND SWORN TO before me this 29 day of May, 19 61

Evelyn D. Evans
Evelyn D. Evans Notary Public.

My commission expires December 12, 1962

