


STATE OF KANSAS
STATE CORPORATION COMMISSION

WELL PLUGGING RECORD

The All Information Completely
Be Required Affidavit
oil or Deliver Report to:
Conservation Division
State Corporation Commission
211 No. Broadway
Wichita, Kansas

Finney County. Sec. 32 Twp. 21 Rge. 32 (E) (W) X
Location as "NE/CNW/SW" or footage from lines S 1/2
Lease Owner Robert F. White
Lease Name Craig Well No. #1
Office Address 714 Union Center Bldg., Wichita, Kansas
Character of Well (completed as Oil, Gas or Dry Hole)
Date well completed 19
Application for plugging filed 3-31-63 19
Application for plugging approved 19
Plugging commenced 3-27-63 19
Plugging completed 3-38-63 19
Reason for abandonment of well or producing formation

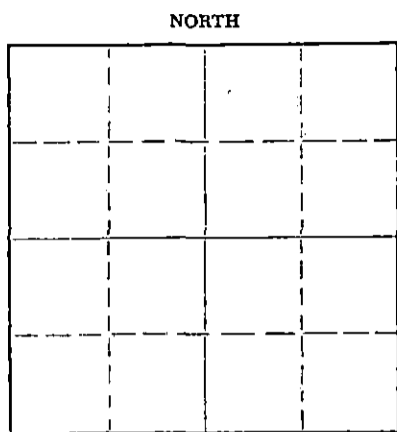

Locate well correctly on above
Section Plat

If a producing well is abandoned, date of last production 19
Was permission obtained from the Conservation Division or its agents before plugging was com-
menced?

Name of Conservation Agent who supervised plugging of this well Hugh E. Scott
Producing formation Depth to top Bottom Total Depth of Well 2700' Feet
Show depth and thickness of all water, oil and gas formations.

OIL, GAS OR WATER RECORDS

CASING RECORD

FORMATION	CONTENT	FROM	TO	SIZE	PUT IN	PULLED OUT

Describe in detail the manner in which the well was plugged, indicating where the mud fluid was placed and the method or methods used
in introducing it into the hole. If cement or other plugs were used, state the character of same and depth placed, from feet to
feet for each plug set.

Washed down 60 gals. of sand, mixed and dumped 5 sacks cement. Displaced same to
2550'. Mixed and dumped 10 sacks cement. Displaced same to 500'. Mudded hole to
50' and sat 10' rock bridge, closed 4 1/2" casing in tight.
Opened 4 1/2" casing slow and bleed gas off. Called Halliburton and squeezed in
15 sacks cement.

RECEIVED
STATE CORPORATION COMMISSION

APR 4 1963

CONSERVATION DIVISION
Wichita, Kansas

(If additional description is necessary, use BACK of this sheet)

Name of Plugging Contractor Southwest Casing Pulling Co., Inc.
Address Box 364, Great Bend, Kansas

STATE OF Kansas, COUNTY OF Barton, ss.
Southwest Casing Pulling Co., Inc. (employee of owner) or (owner or operator) of the above-described
well, being first duly sworn on oath, says: That I have knowledge of the facts, statements, and matters herein contained and the log of the
above-described well as filed and that the same are true and correct. So help me God.

(Signature) W. C. Spencer
Box 364, Great Bend, Kansas
(Address)

SUBSCRIBED AND SWORN TO before me this 3 day of April, 1963

My commission expires 24 October 1964
Sidney D. Miller
Notary Public.


WELL LOG BUREAU - KANSAS GEOLOGICAL SOCIETY
508 East Murdock, Wichita, Kansas

Company - ROBT. F. WHITE
Farm - Craig No. 1

SEC. 32 T. 21 R. 32W
C SW

Total Depth. 2684'
Comm. 7-13-59 Comp. 7-25-59
Shot or Treated.
Contractor. Garvey Drlg.
Issued. 8-12-61

County Finney
KANSAS

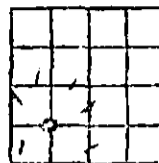

CASING:
8" 263'
4" 2684'

Elevation. 2889' RB

Production. 2,500,000 CFG

Figures Indicate Bottom of Formations.

COMPLETE DRILLERS LOG NOT AVAILABLE:

TOPS: SCOUT
Herington 2613
Krider 2644
Total Depth 2684

RECEIVED
STATE CORPORATION COMMISSION
JAN 30 1968
CONSERVATION DIVISION
Wichita, Kansas

J. D. McKelvey
70 37957
Bob White