


STATE OF KANSAS
STATE CORPORATION COMMISSION

Give All Information Completely
Make Required Affidavit
Mail or Deliver Report to:
Conservation Division
State Corporation Commission
211 No. Broadway
Wichita, Kansas

15-055-10204-0000
WELL PLUGGING RECORD

Finney County, Sec. 8 Twp. 23-S Rge. 31 (E) W (W)
C SE/4

NORTH

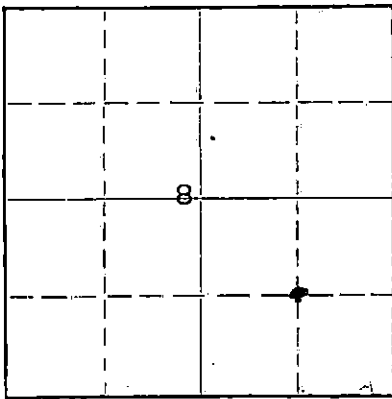

Locate well correctly on above Section Plat

Location as "NE/CNW/SW" or footage from lines _____
Lease Owner Apache Corporation
Lease Name Sherman Unit Well No. 1
Office Address 823 South Detroit, Tulsa, Oklahoma 74120
Character of Well (completed as Oil, Gas or Dry Hole) Gas
Date well completed September 18 19 61
Application for plugging filed March 10 19 64
Application for plugging approved March 11 19 64
Plugging commenced March 23 19 64
Plugging completed March 25 19 64
Reason for abandonment of well or producing formation Marginal gas well; no market available.
If a producing well is abandoned, date of last production No production 19 _____
Was permission obtained from the Conservation Division or its agents before plugging was commenced? Yes

Name of Conservation Agent who supervised plugging of this well Mr. Hugh Scott
Producing formation Krider Depth to top 2673 Bottom 2690 Total Depth of Well 2690 Feet
Show depth and thickness of all water, oil and gas formations.

OIL, GAS OR WATER RECORDS

CASING RECORD

FORMATION	CONTENT	FROM	TD	SIZE	PUT IN	PULLED OUT
Base Stone Coral		2073		8-5/8	344	None
Hollenberg		2644		4-1/2	2689	2255
Herrington		2667				
Krider		2673	2690			

Describe in detail the manner in which the well was plugged, indicating where the mud fluid was placed and the method or methods used in introducing it into the hole. If cement or other plugs were used, state the character of same and depth placed, from _____ feet to _____ feet for each plug set.

Pumped 10 sacks cement to 2431', followed with rubber plug and wire line.
Filled hole and spotted 35 sacks cement across shoe of 8-5/8"OD 390 to 280'.
Spotted 15-sack cement plug 0' to 45' in top of 8-5/8"OD surface casing.

RECEIVED
STATE CORPORATION COMMISSION

APR 24 1964

CONSERVATION DIVISION
Wichita, Kansas

(If additional description is necessary, use BACK of this sheet)

Name of Plugging Contractor Daco Lease and Well Service
Address 1700 South Main Street, Borger, Texas

STATE OF Oklahoma, COUNTY OF Tulsa, ss.
Geo. J. McLernon, Jr. (employee of owner) or (owner or operator) of the above-described well, being first duly sworn on oath, says: That I have knowledge of the facts, statements, and matters herein contained and the log of the above-described well as filed and that the same are true and correct. So help me God.

(Signature) [Signature] x
823 South Detroit, Tulsa, Oklahoma 74120
(Address)

SUBSCRIBED AND SWORN to before me this 23rd day of April, 19 64

My commission expires January 7, 1967.

Notary Public.

APACHE CORPORATION - Operator

SIERRA PETROLEUM CO., INC - Contr.

SHEPHERD UNIT #1
G SE
Sec. 8-23S-31W
Finney County, Kansas

T. D.: 2690'

Commenced: 7-27-61
Completed: 8-1-61

Casing:

8-5/8" Set at 343'
4-1/2" Set at 2689'

Cement:

with 300 sx w/ HA-5
with 75 sx Conson

FORMATION

DEPTH

Sand & Gravel	160
Sand & Shale	344
Shale	650
Shale & Shells	1745
Red Bed & Shale	2014
Anhydrite	2020
Red Rock & Shale	2054
Lime, Red Rock & Shells	2220
Red Bed & Shale	2355
Shale & Lime	2385
Lime & Sand	2540
Sandy Lime	2628
Lime & Sandy Shale	2690

RECEIVED
STATE CORPORATION COMMISSION

MAR 11 1964

CONSERVATION DIVISION
Wichita, Kansas

STATE OF KANSAS)
) ss:
COUNTY OF RUSSELL)

I hereby certify that the above information is true
and correct to the best of my knowledge.

C. T. Hensker

Subscribed to and sworn to before me this 3rd day of August
1961.

Leroy Dietz
Notary Public

My commission expires: 10-17-63