


STATE OF KANSAS
STATE CORPORATION COMMISSION

Give All Information Completely
Make Required Affidavit
Mail or Deliver Report to:
Conservation Division
State Corporation Commission
212 No. Market
Wichita, Kansas 67202

15-055-20016-0000 Form CP-4

WELL PLUGGING RECORD

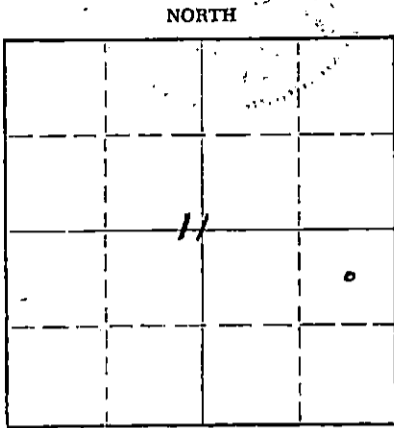

Locate well correctly on above Section Plat

Finney County, Sec. 11 Twp. 23 Rge. 31 (E) W (W)
Location as "NE/CNW%SW%" or footage from lines NE SE
Lease Owner Davidor & Davidor, Inc.
Lease Name Sherman #1 Well No. 1
Office Address Oklahoma City, Oklahoma
Character of Well (completed as Oil, Gas or Dry Hole) Dry Hole
Date well completed 19
Application for plugging filed 19
Application for plugging approved 12/29/69 19
Plugging commenced 1/4/70 19
Plugging completed 1/12/70 19
Reason for abandonment of well or producing formation ~~Completed~~
Inability to complete well as commercial producer.
If a producing well is abandoned, date of last production 19
Was permission obtained from the Conservation Division or its agents before plugging was commenced? yes

Name of Conservation Agent who supervised plugging of this well Eaves
Producing formation Morrow Depth to top 4770' Bottom 4778' Total Depth of Well 1820 Feet
Show depth and thickness of all water, oil and gas formations.

OIL, GAS OR WATER RECORDS

CASING RECORD

FORMATION	CONTENT	FROM	TO	SIZE	PUT IN	PULLED OUT
				8-5/8	348'	none
				4 1/2"	4815'	2679'

Describe in detail the manner in which the well was plugged, indicating where the mud fluid was placed and the method or methods used in introducing it into the hole. If cement or other plugs were used, state the character of same and depth placed, from feet to feet for each plug set.

Checked hole, sanded hole to 4760', set 5 sacks of cement.
Loaded hole with water, shot pipe at 3502', 3408', 3191', 3093',
2997', 2900', 2747', 2639', pulled 85 joints. Bailed hole to 350',
set rock bridge and ran 25 sacks of cement. Mudded hole to 40',
ran 10 sacks of cement.

PLUGGING COMPLETE.


RECEIVED
STATE CORPORATION COMMISSION
JAN 30 1970
CONSERVATION DIVISION
Wichita, Kansas

(If additional description is necessary, use BACK of this sheet)
Name of Plugging Contractor KNIGHT CASING PULLING CO., INC.
Address CHASE, KANSAS

STATE OF KANSAS, COUNTY OF RICE, ss.
Noel J. Knight (employee of owner) or (owner or operator) of the above-described well, being duly sworn on oath, says: That I have knowledge of the facts, statements, and matters herein contained and the log of the above-described well as filed and that the same are true and correct. So help me God.

(Signature) Noel Knight
Chase, Kansas (Address)

SUBSCRIBED AND SWORN to before me this 19th day of November, 1970

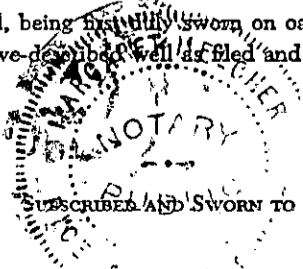

Margaret Melcher
Notary Public.

My commission expires 2/15/71