

STATE OF KANSAS
STATE CORPORATION COMMISSION

WELL PLUGGING RECORD

Give All Information Completely
Make Required Affidavit
Mail or Deliver Report to
Conservation Division
State Corporation Comm.
245 North Water
Wichita, KS 67202

Finney County. Sec. 7 Twp. 23 Rge. 30 E/W
Location as "NE/CNW $\frac{1}{2}$ SW $\frac{1}{2}$ " or footage from lines C-NW-NW

Lease Owner Challenger
Lease Name Bulger Well No. 1

Office Address 727 Mayo Bldg. 420 S. Main Tulsa, Okla. 74103

Character of Well (Completed as Oil, Gas or Dry Hole) Dry Hole

Date Well completed 8-6 1981

Application for plugging filed 8-6 1981

Application for plugging approved 8-6 1981

Plugging commenced 8:00 A.M. 8-6 1981

Plugging completed 12 Noon 8-6 1981

Reason for abandonment of well or producing formation Dry Hole


If a producing well is abandoned, date of last production 19

Was permission obtained from the Conservation Division or its agents before plugging was commenced? Yes

Name of Conservation Agent who supervised plugging of this well Tommy Thomas

Producing formation _____ Depth to top _____ Bottom _____ Total Depth of Well 4970

Show depth and thickness of all water, oil and gas formations.

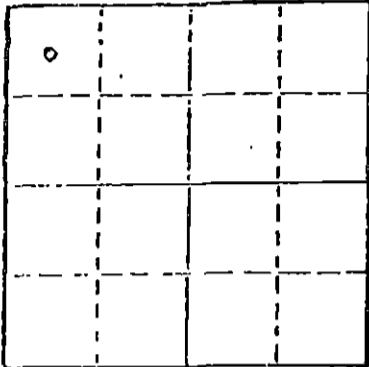

Locate well correctly on above Section Plot

OIL, GAS OR WATER RECORDS

CASING RECORD

FORMATION	CONTENT	FROM	TO	SIZE	PUT IN	PULLED OUT
				8 5/8"	375'	Left

Describe in detail the manner in which the well was plugged, indicating where the mud fluid was placed and the method or methods used in introducing it into the hold. If cement or other plugs were used, state the character of same and depth placed, from _____ feet to _____ feet for each plug set.


- Plug with 60 Sx. @ 1260'
- Push rubber plug to 360' then 35' Sx.
- 25 Sx. @ 180'
- 10 Sx. @ 40' to 0'
- 5 Sx. Rathole

(If additional description is necessary, use BACK of this sheet)

Name of Plugging Contractor Lakin Drilling

STATE OF Kansas COUNTY OF DeWey, ss. L. E. Blankenship (employee of owner) or (owner or operator)

of the above-described well, being first duly sworn on oath, says: That I have knowledge of the facts, statements, and matters herein contained and the log of the above-described well as filed and true and correct. So help me God.

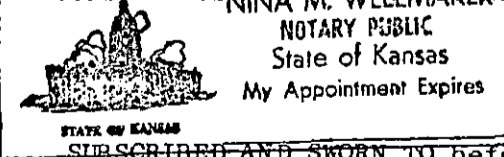

(Signature) L. E. Blankenship

(Address) _____

SUBSCRIBED AND SWORN TO before me this 12 day of August, 19 81

Nina M. Wellmaker
Notary Public.

My commission expires 6-15-85

RECEIVED
STATE CORPORATION COMMISSION

AUG 17 1981

CONSERVATION DIVISION
Wichita, Kansas

OPERATOR: Challenger Minerals Inc.
 CONTRACTOR: Lakin Drilling Co.
 WELL NAME: Bulger # 1
 LOCATION: G-NW-NW 7-23-30
Finney County Kansas
 GEOLOGIST: _____
 SPUD DATE: 7-22-81
 COMPLETION DATE: 8-6-81

FOOTAGE:		
<u>0</u>	<u>300</u>	<u>Clay & Sand</u>
<u>300</u>	<u>375</u>	<u>Shale</u>
<u>375</u>	<u>1548</u>	<u>Shale Gyp & Sd.</u>
<u>1548</u>	<u>1762</u>	<u>Salt</u>
<u>1762</u>	<u>2050</u>	<u>Shale & Anhy</u>
<u>2050</u>	<u>2066</u>	<u>Anhy</u>
<u>2066</u>	<u>2304</u>	<u>Shale & Anhy</u>
<u>2304</u>	<u>2601</u>	<u>Shale & Lime</u>
<u>2601</u>	<u>3522</u>	<u>Shale & Chalky Lime</u>
<u>3522</u>	<u>4646</u>	<u>Lime With Shale & Chalk</u>
<u>4646</u>	<u>4970</u>	<u>Lime -Chert.</u>
<u>4970</u>	<u>T.D.</u>	_____
_____	_____	_____
_____	_____	_____

REPORT: Spud in @ 7:00 P.M. 7-22-81 12 $\frac{1}{4}$ " hole to 375'
 Ran 9 Jts. 8 5/8" 20# Csg. Set @ 375' Cement with 280 Sx. "H" & 3/8 c.c.
 By Howco - Plug down @ 4:00 P.M. 7-22-81

Logged Hole - Plugged & Abandoned-

Plugged with

60 Sx. @ 1260'

Pushed Rubber Plug to 360' - 35 Sx. @ 360

25 Sx. @ 180'

10 Sx. @ 40' to 0

5 Sx. Rathole - Job by Howco. Completed @ 12:00
 Noon 8-6-81


State of Kansas County of Kearny

Louis C Blankenship, Drilling Supt for Lakin Drilling Co, does hereby state that
 the above and foregoing is a true and correct copy of the log of the Bulger # 1
lease; 7-23-30 (legal); Finney (county); Kansas.

LAKIN DRILLING COMPANY

By: Louis C Blankenship
 Louis C Blankenship, Drilling Supt.

Subscribed and sworn to before me, a Notary Public, in and for the aforesaid county
 and state as of this 10th day of August, 19 81.

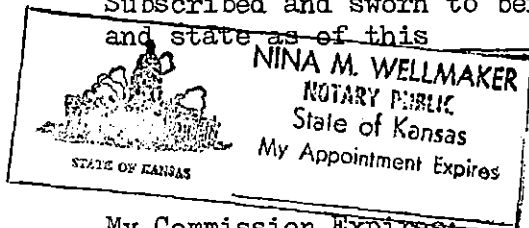

Nina M. Wellmaker
 Notary Public

My Commission Expires: 6-15-85

RECEIVED
 STATE CORPORATION COMMISSION

AUG 17 1981

CONSERVATION DIVISION
 Wichita, Kansas